

F. Hedley Barnhill

Service No. 13 853

Address ~~14 Ashland Street, Arlington~~

5 Robbins Rd

Location 5 Robbins Road

Kind of Pipe

Size 6"

Size of Main 8"

Repair—Renewal—New Service

Location

Date 1938	Material	Amount	Total	Date	Amount
5/23/38	16 hrs. @ 50¢	8 00		May 17, 1938 Deposited	57.00
<i>Sum 7-5-38</i>	42 " @ 55¢	23 10			
	18 " @ 60¢	<u>10 80</u>	41 90		
	10% Overhead		4 19		
	52' 6" Sewer Pipe @ 20¢		10 40		
	1 6" <u>Y</u>		1 00		
	1 6" Plug		10		
	Jointing Compound		3 12		
	Trucking - 2 hrs. @ 75¢		<u>1 50</u>		
			62 21		
	Flat Rate:	\$57.00			
	Labor				

Hedley Press, Inc., Lexington

TOWN OF LEXINGTON - BOARD OF PUBLIC WORKS

SEWER DIVISION

DATE May 16 1938

NO. _____

The undersigned applies for the construction of a particular sewer connecting No. 5 Robbins Road Street and hereby agrees to comply with the Rules and Regulations governing the construction and use of Particular Sewers, as now or at any future time established by the Board of Selectmen.

Am't. of Estimate \$ 57.00 for 5' set back.


Am't. Paid \$ _____

F. H. Barnhill Owner
14 Ashland St. Cal.

owner dig trench.

Sketch of Service Here

5

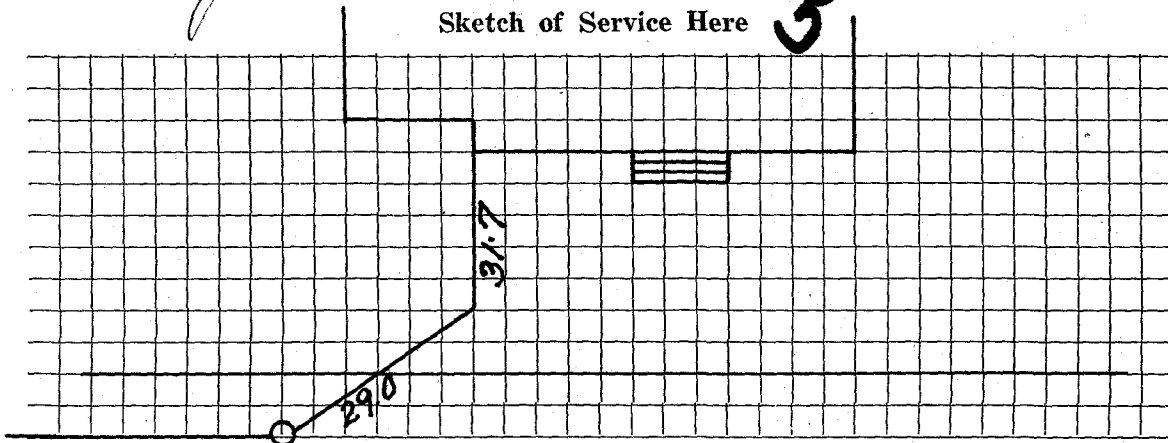

Connection made in _____ Street.

Work completed _____ 19

Remarks:

156