

TOWN OF LEXINGTON—BOARD OF PUBLIC WORKS

SEWER DIVISION

DATE Feb 11, 1942

NO. 66 Robbin Road

The undersigned applies for the construction of a particular sewer connecting No. 66 Robbin Road Street and hereby agrees to comply with the Rules and Regulations governing the construction and use of Particular Sewers, as now or at any future time established by the Board of Selectmen.


Am't. of Estimate \$ 75⁰⁰ *Does not include ledge.*

Am't. Paid \$ _____

Edwin H Nelson Owner

Sketch of Service Here

66

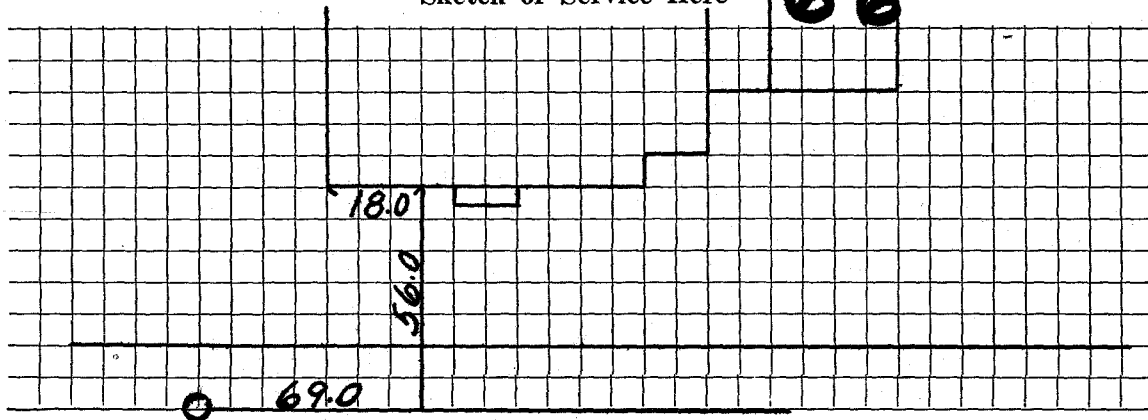

*68
2/11/42*

*68
2/3*

Connection made in _____ Street.

Work completed _____ 19

Remarks: