

Name Herbert Collins

Service No. 183

Address 76 Robbins Road

76 Robbins Rd.

Location

Comm. 4/29/57

Kind of Pipe

Size 6"

Size of Main 8"

~~Repair~~ Renewal—New Service

Location

Date	Material	Amount	Total	Date	Amount
12-28-56	labor	53 07		12-12-56	Deposit \$ 300 00
12-29-56		59 37		4-29-57	Refund 20 87
2-28-57		<u>14 68</u>	127 12		\$ 279 13
	10% overhead		12 71		
	56' 6" Sewer pipe @.435		24 36		
	Joint compound		3 36		
	12 1/3 hrs. Littlefield @8.50		104 83		
	5 hrs. trucking @ .75		3 75		
	1 hrs. Roger's Trailer @3.00		3 00		
			<u>279 13</u>		
	Labor				

TOWN OF LEXINGTON—DEPT. OF PUBLIC WORKS

SEWER DIVISION

DATE

NO.


The undersigned applies for the construction of a particular sewer connecting No. Street and hereby agrees to comply with the Rules and Regulations governing the construction and use of Particular Sewers, as now or at any future time established by the Board of Selectmen.

Am't of estimate \$.

Am't Paid \$.

..... Owner

Sketch of Service Here

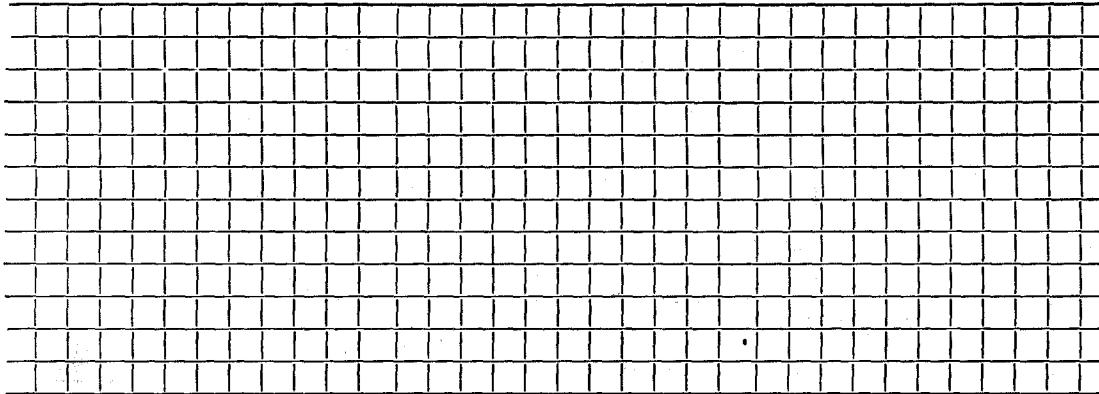

Connection made in Street.

Work completed 19..

Remarks: