

Name M. M. Webb

Service No. 12 869

Address ~~496 Mass. Avenue~~

79 Robbins Rd

Location 79 Robbins Road

Kind of Pipe

Size 6"

Size of Main 8"

Repair—Renewal—New Service

Location

Date 1939	Material	Amount	Total	Date	Amount
Aug. 21.	14 hrs. @ 50¢	7 00		August 8, 1939	35 00
9/11/39	29½ " 55¢	16 23		Deposited	
	31½ " 60¢	18 90			
	5 " 70¢	3 50	45 63		
	10% Overhead		4 56		
	50' 6" Sewer Pipe @ 20¢		10 00		
	Jointing Compound		3 00		
	2 hrs. Trucking @ 75¢		1 50		
			64 59		
	Charge: \$35.00				
	(See job slip)				
	Labor				

Hadley Press, Inc., Lexington

25" Spot repair 10/9/19
PVC w/ 2 PVC to clay fern Co's.

TOWN OF LEXINGTON—BOARD OF PUBLIC WORKS
SEWER DIVISION


DATE Aug 8. 1939

The undersigned applies for the construction of a particular sewer connecting No. 79 Robbins Road Street and hereby agrees to comply with the Rules and Regulations governing the construction and use of Particular Sewers, as now or at any future time established by the Board of Selectmen.

Am't. of Estimate \$ _____

Am't. Paid \$ _____

M. M. Webb. Owner

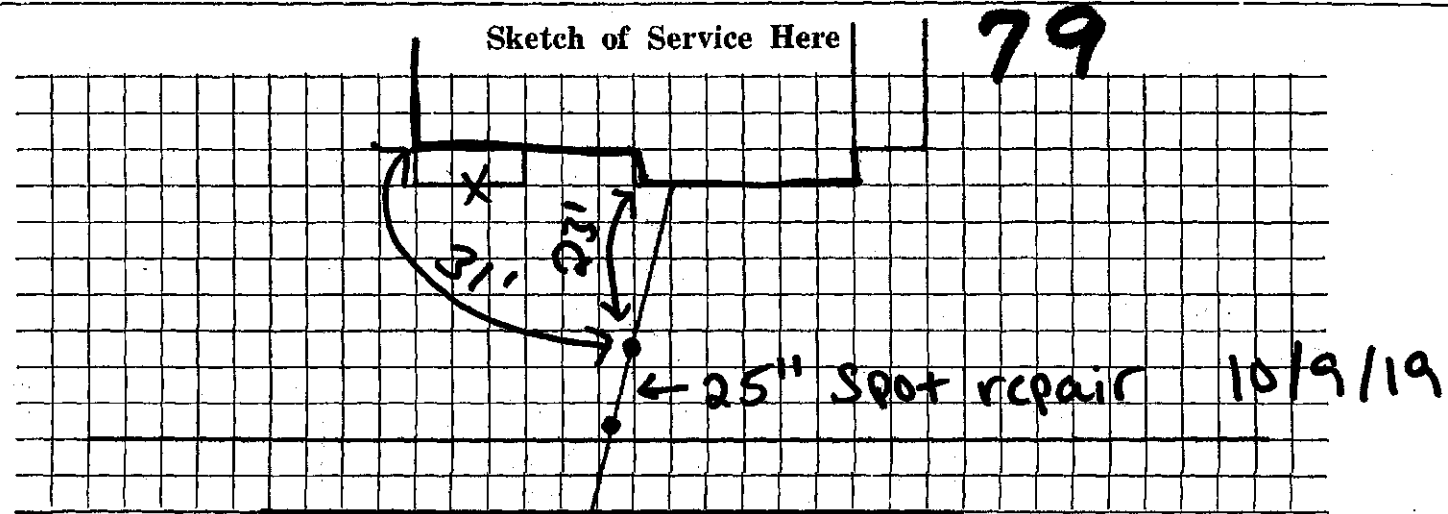

Connection made in _____ Street.

Work completed _____ 19

Remarks: