

Name J. G. Realty Trust

Service No. 56

Address 80 Robbins Road

80 Robbins Rd.

Location

Kind of Pipe

Size 6"

Size of Main 8"

~~Renewal~~ New Service W.O. #699 DeFlice #3407

Location

DEC 3 1979


Date	Material	Amount	Total	Date	Amount
9-5-79	Labor	105.72		8-15-79	Deposit 300.00
	10% O.H.	10.57	116.29	12-3-79	Paid by W.O. #699 27.18
10'	6" Transite pipe @ 1.91		19.10		327.18
1	5' Nipple @2.45		12.25		
1	2' Nipple		7.60		
1	6" Nipple		1.93		
1	22 $\frac{1}{2}$ ° Transite Elbow		4.34		
1	90° Transite Elbow		6.21		
1	6" Transite Adaptor		7.53		
1	6" Plug		2.95		
$\frac{1}{2}$	bag Cement		2.00		
2	hrs. Trucking @3.00		6.00		
2	hrs. Backhoe @6.50		13.00		
	Hot Top 24' x 8'		127.98		
10-3-79	40' 6" Transite pipe		327.18		
10'	4" Cast Iron pipe				

DATE _____

TOWN OF LEXINGTON — BOARD OF PUBLIC WORKS
SEWER DIVISION

Sketch of Service Here

80

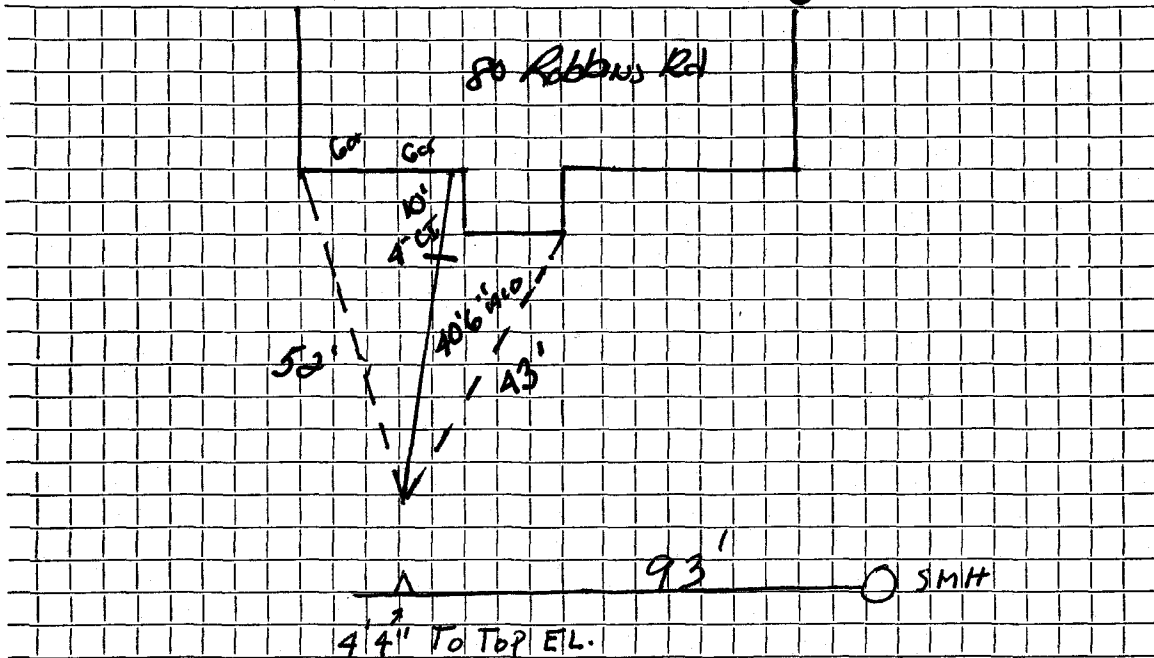

Connection made in Street. Work completed

Remarks:

.....

.....