

Name Mr. Henry Brask

Service No. 19 855

Address e/o C. A. Estey, 52 Grand View Rd., Arlington.

9 Robbins Rd

Location Henry Brask Lot 20 Robbins Rd.

#9 Robbins Rd

Kind of Pipe

Size 6"

Size of Main 8"

~~Repair~~ Renewal - New Service

Location

Date	Material	Amount	Total	Date	Amount
7-58-50	42' 6" Sewer Pipe @.25	10 50			
10-27-31	Sulphur & Jute	1 68			
	Trucking	75	12 93		
9/2/31	72 Hrs. Labor @.55	39 60			
	8 " " @.60	4 80	44 40		
	15% Overhead		6 66		
			63 99		
			Say \$58 50		
	Labor				

Aug 28 1931 - Cash 58 50

Hadley Press, Inc., Lexington

TOWN OF LEXINGTON—BOARD OF PUBLIC WORKS

SEWER DIVISION

DATE August 28, 1931.

NO. _____


The undersigned applies for the construction of a particular sewer connecting No. Lot 24, Robbins Road Street and hereby agrees to comply with the Rules and Regulations governing the construction and use of Particular Sewers, as now or at any future time established by the Board of Selectmen.

Am't. of Estimate \$ _____

Am't. Paid \$ 90 for water & sewer

Henry Beck Owner
By E. E. Etey

Sketch of Service Here

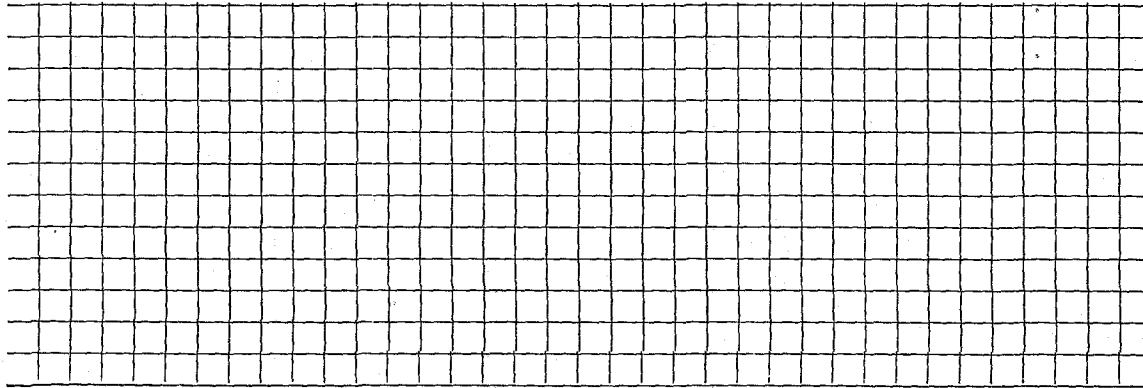

Connection made in _____ Street.

Work completed _____ 19

Remarks: