


DATE _____

TOWN OF LEXINGTON — BOARD OF PUBLIC WORKS
SEWER DIVISION

Sketch of Service Here **14**

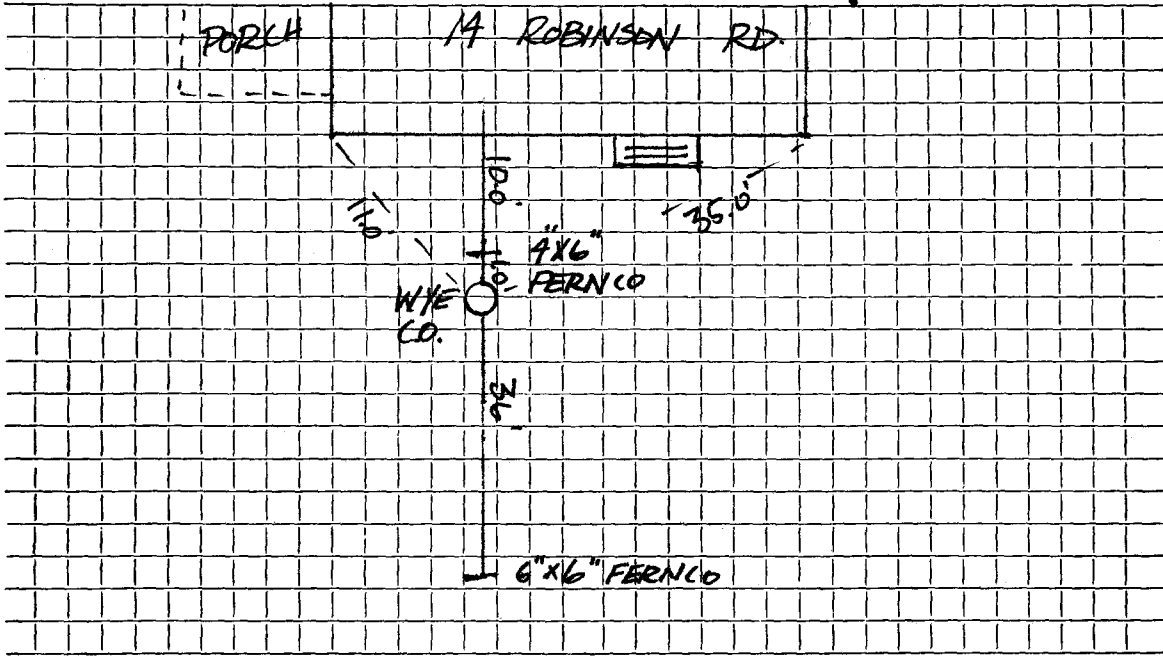

Connection made in Street. Work completed

Remarks: Original Service 11-7-72 (29'-6" Transite, 16'-4" C.I. Pipe.)