


DATE AUGUST 1986

TOWN OF LEXINGTON — BOARD OF PUBLIC WORKS
SEWER DIVISION

Sketch of Service Here **23**

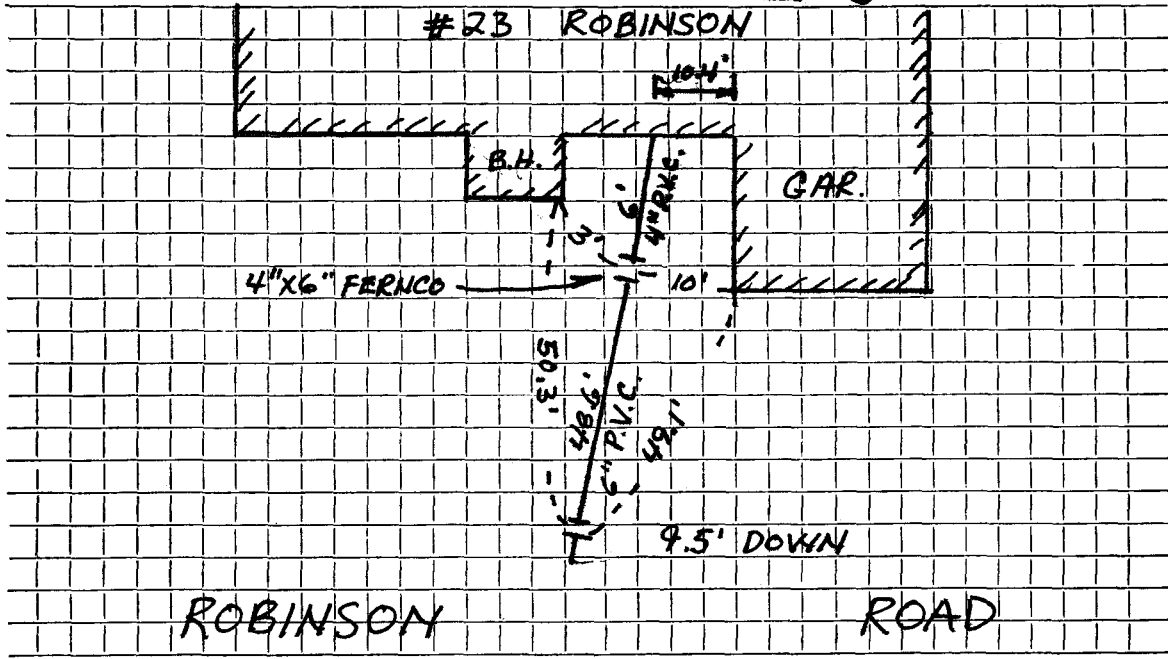

Connection made in ... ROBINSON ROAD ... Street. Work completed ... GATELY

Remarks:

.....

.....

BACK OF LL