


DATE 8/4/80

TOWN OF LEXINGTON — BOARD OF PUBLIC WORKS
SEWER DIVISION

Sketch of Service Here **24**

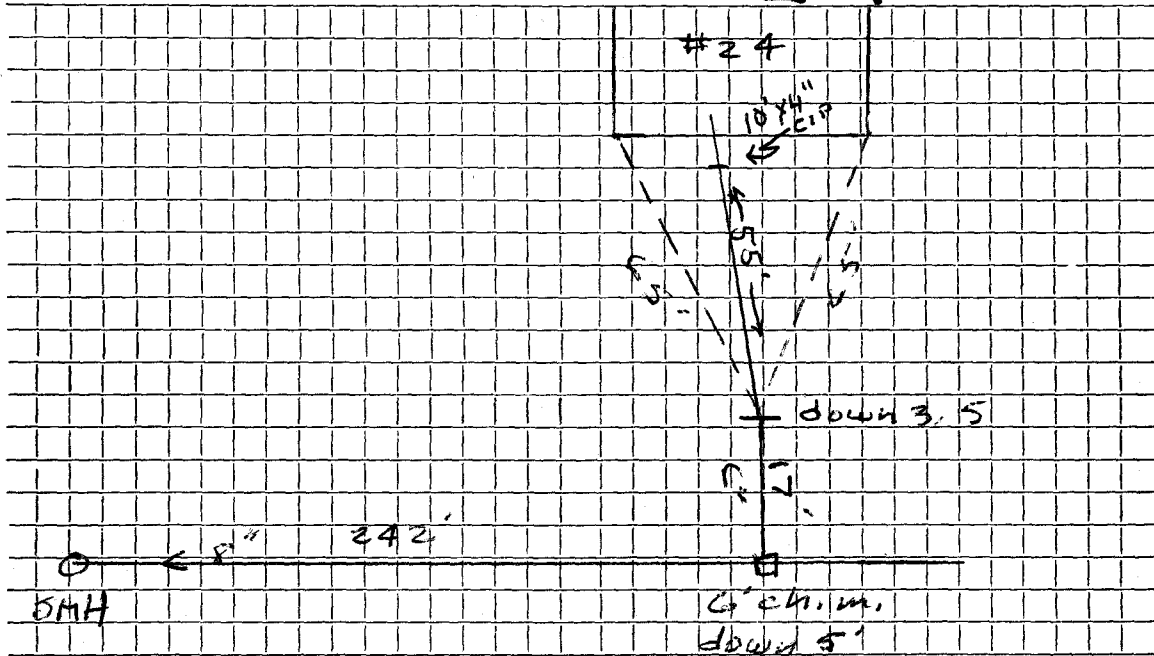

Connection made in ROBINSON RD. Street. Work completed

Remarks: First 10' conc. encased

.....
.....