




DATE 8/4/80

TOWN OF LEXINGTON — BOARD OF PUBLIC WORKS  
SEWER DIVISION

Sketch of Service Here **25**

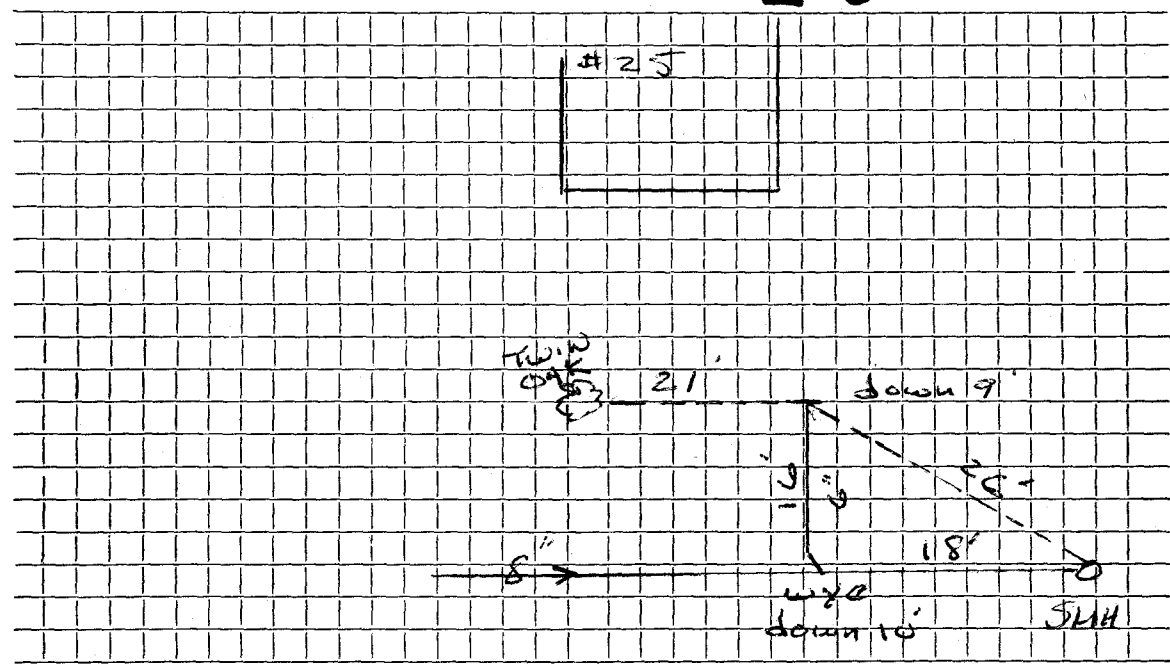

Connection made in ROBINSON RD. Street. Work completed .....

Remarks: .....