


TOWN OF LEXINGTON — BOARD OF PUBLIC WORKS
SEWER DIVISION

Sketch of Service Here

28

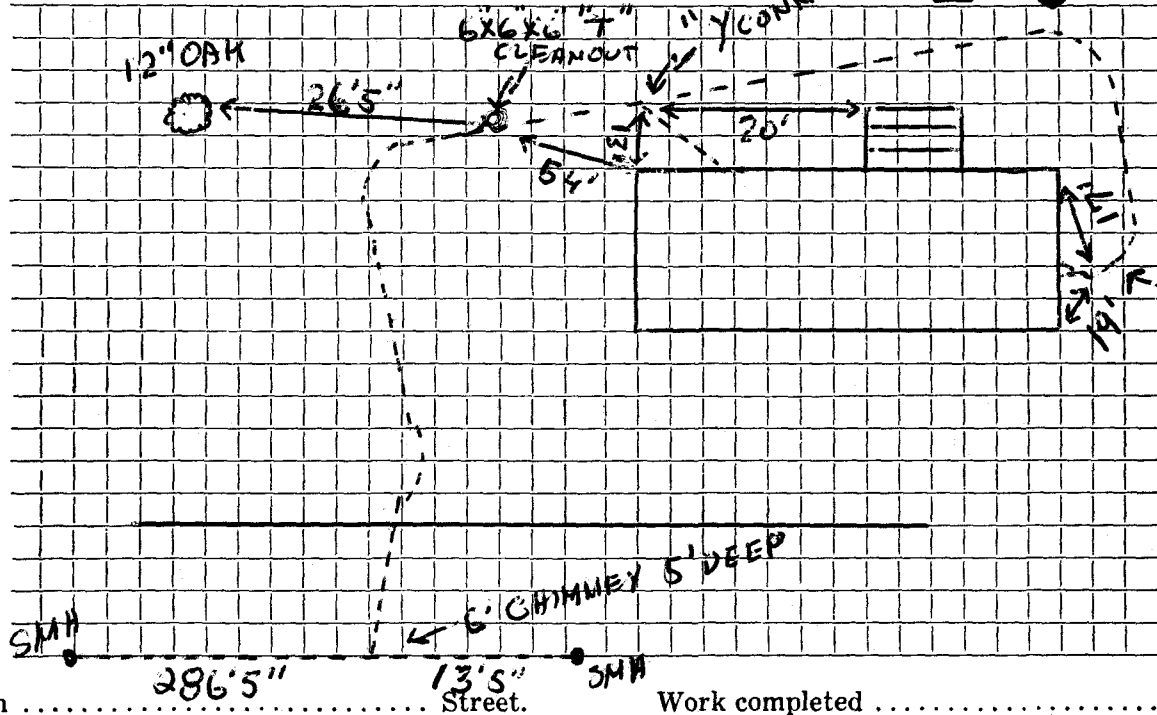

6" X 6" X 6" "T"
CLEAN OUT

Connection made in 286'5" Street. Work completed

Remarks:
.....
.....