


DATE 8/9/80

TOWN OF LEXINGTON — BOARD OF PUBLIC WORKS

SEWER DIVISION

Sketch of Service Here

33

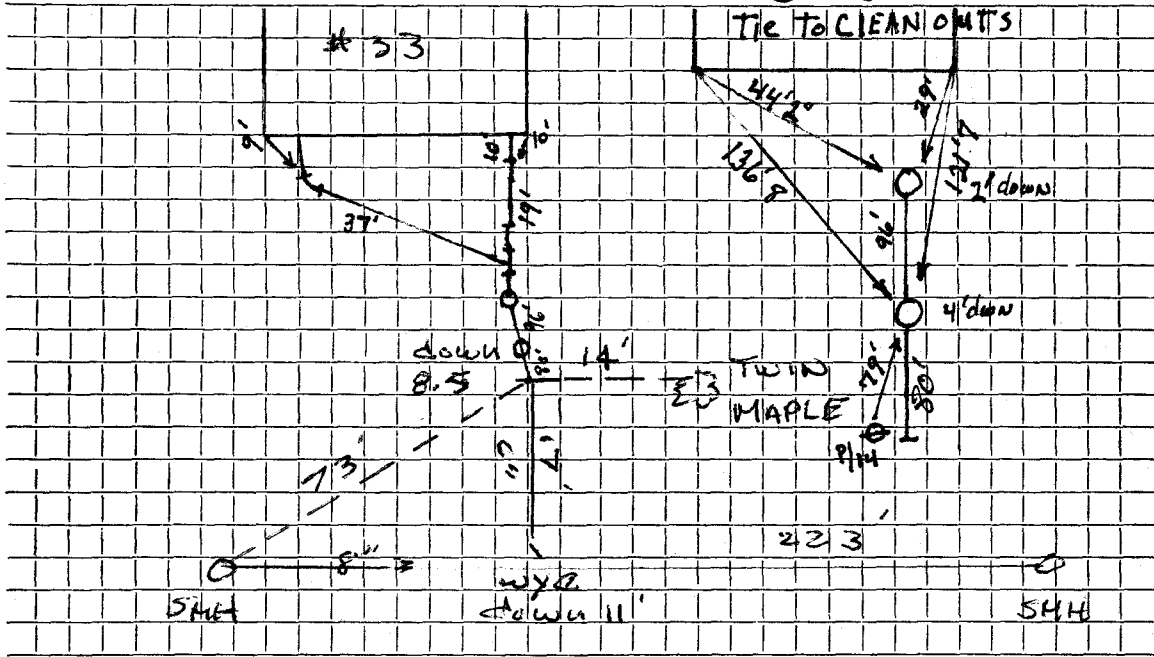

Connection made in ROBINSON RD. Street. Work completed

Remarks: pitch house to main.