

Name

Service No.

Address

39 ROBINSON RD

Location

Kind of Pipe

Size

Size of Main

Repair—Renewal—New Service


Location

Date	Material	Amount	Total	Date	Amount
2.30.05	13'-6" AC @	\$15.00 =	195.00		
2.27.01	Inside installed				
	10'-4" PVC				
	277'-6" PVC				
	1- 4x6 PVC to PVC FERNCO				
	2- 6x6x6 wye clean outs				
	1- 6x6 AC to PVC FERNCO				

DATE _____

TOWN OF LEXINGTON — BOARD OF PUBLIC WORKS

SEWER DIVISION

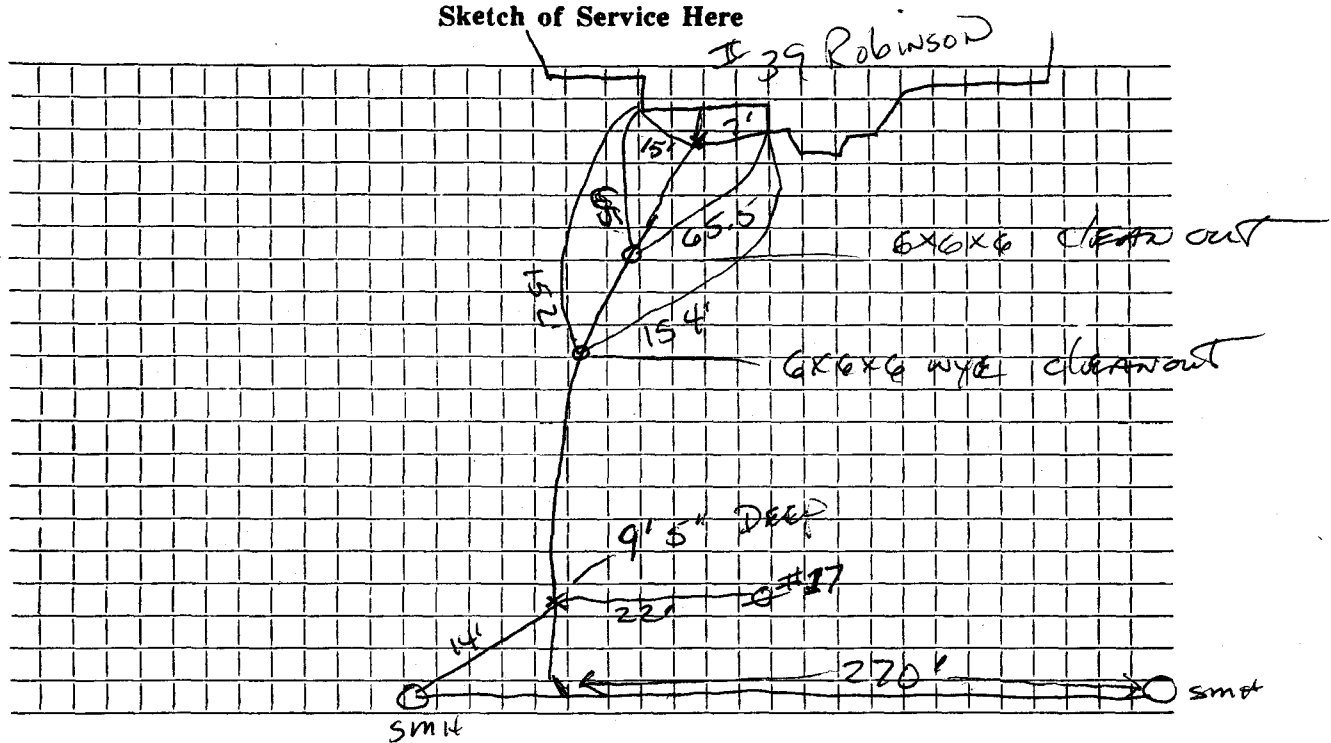


Connection made in Street. Work completed

Remarks: *House torn down NEW ONE put up*

DATE 8/4/80

TOWN OF LEXINGTON — BOARD OF PUBLIC WORKS
SEWER DIVISION

Sketch of Service Here **39**

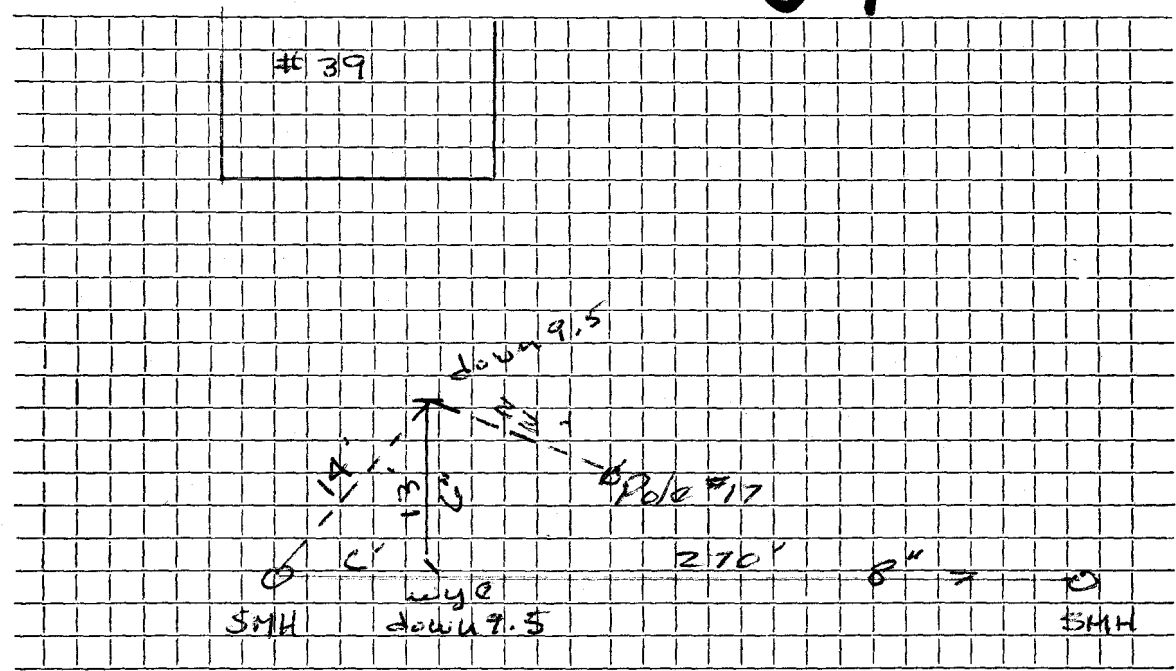

Connection made in ROBINSON RD Street. Work completed


Remarks:

DATE 8/4/80

TOWN OF LEXINGTON — BOARD OF PUBLIC WORKS
SEWER DIVISION

Sketch of Service Here

39

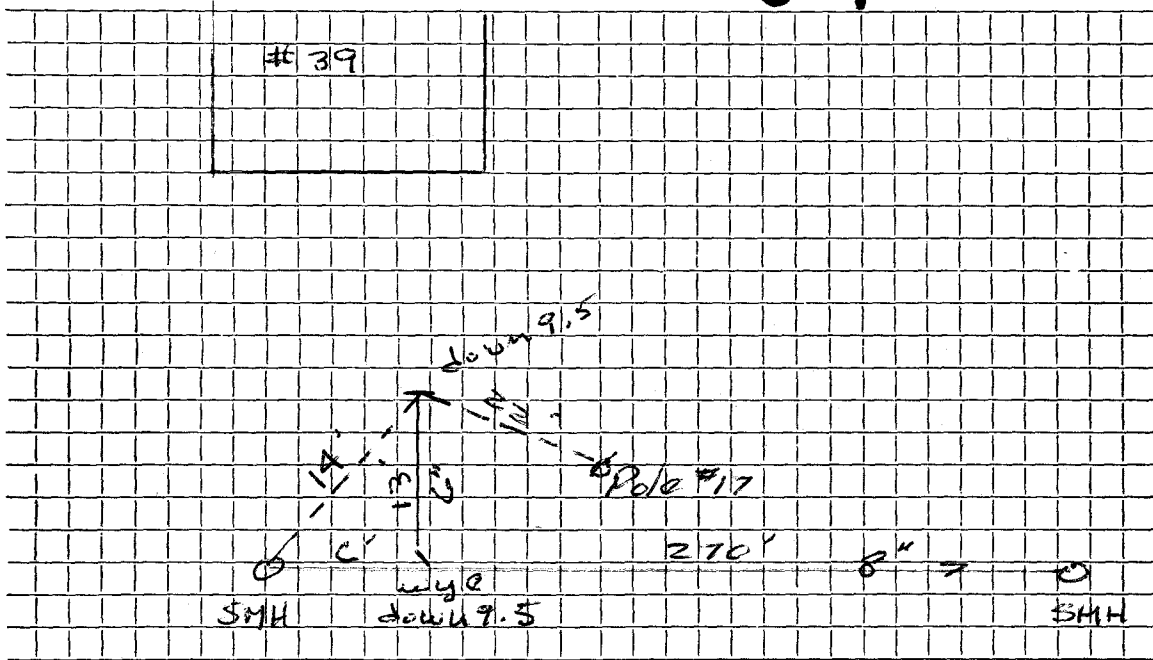

Connection made in ROBINSON RD Street. Work completed

Remarks:
.....
.....