


DATE 10/3/94

TOWN OF LEXINGTON — BOARD OF PUBLIC WORKS
SEWER DIVISION

Sketch of Service Here **40**

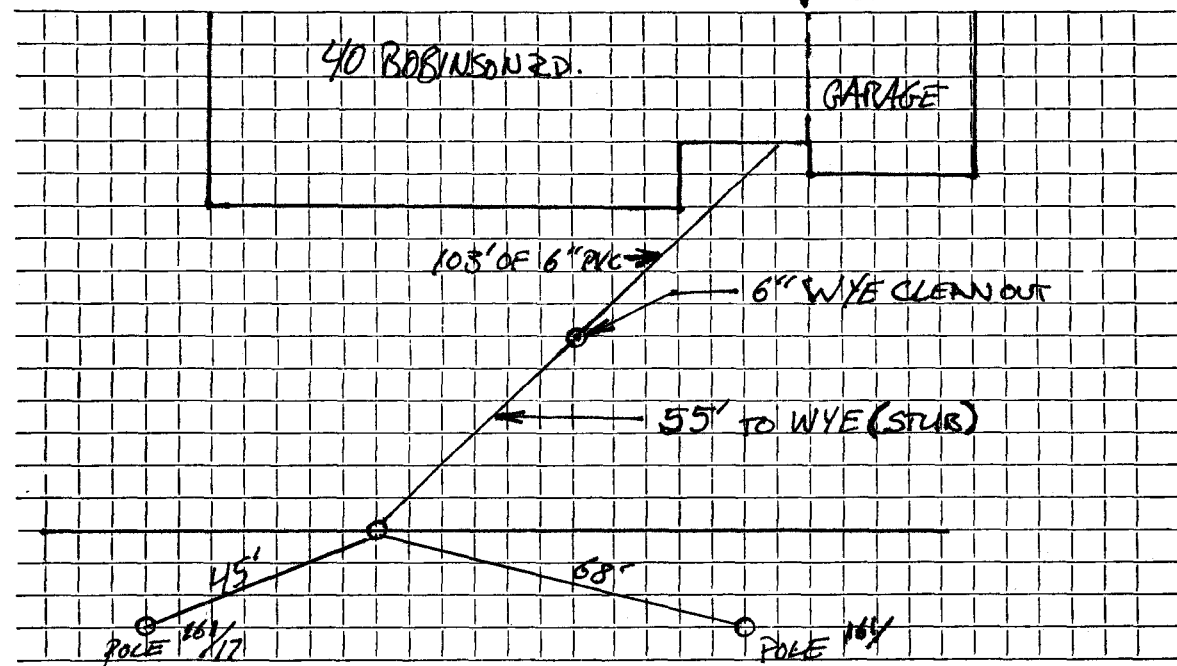


Connection made in Street. Work completed

Remarks:
.....
.....

DATE 8/4/80

TOWN OF LEXINGTON — BOARD OF PUBLIC WORKS
SEWER DIVISION

Sketch of Service Here

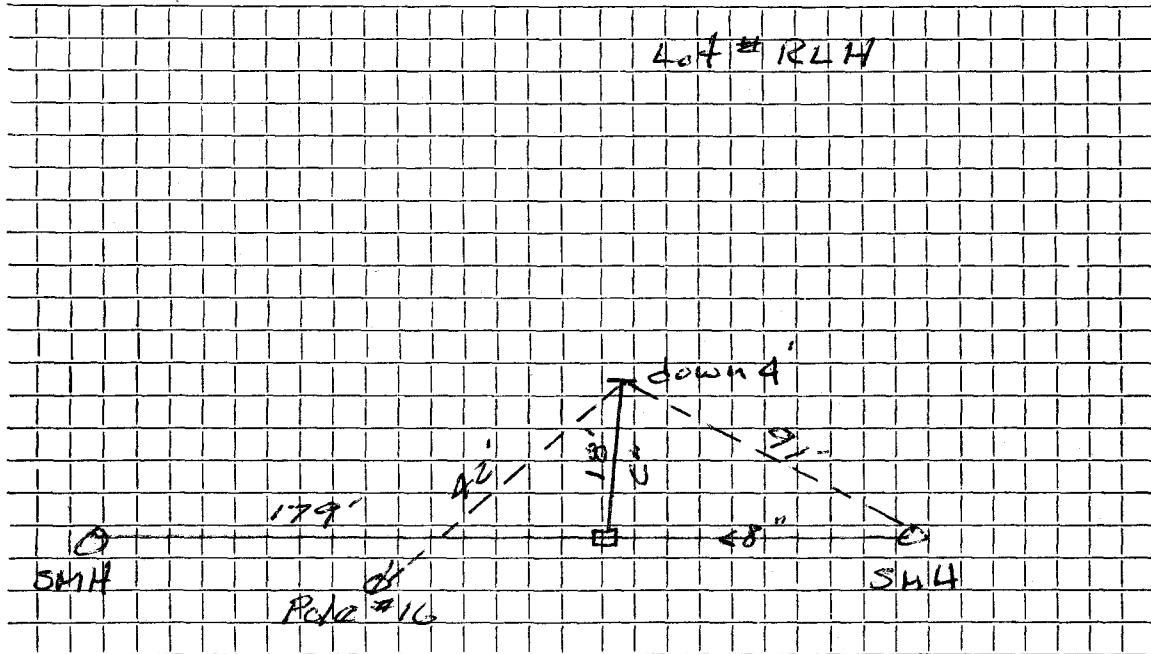

Connection made in ROBINSON RD Street. Work completed

Remarks:

.....

.....