

Name Daniel Brzezinski

Service No. 76

Address 43 Robinson Road

43 ROBINSON ROAD

Location

Kind of Pipe A.C.

Size 6"

Size of Main 8"

~~Repair/Rebuild~~ New Service Great Northern #3553

Location NOV 24 1981


Date	Material	Amount	Total	Date	Amount
7/29/80	15' 6" A.C. pipe @ \$15.00		225.00	11-13-80	225.00
12/5/80	250' P.V.C. pipe				
	235' 6" P.V.C.				
	15' 6" A.C. (on street)				
	3 45° Elbows				
	1 45° Sweep				
	1 Wye for cleanout				
	5' 4" Iron with cleanout				

DEPART

TOWN OF LEXINGTON — BOARD OF PUBLIC WORKS
SEWER DIVISION

Sketch of Service Here

43

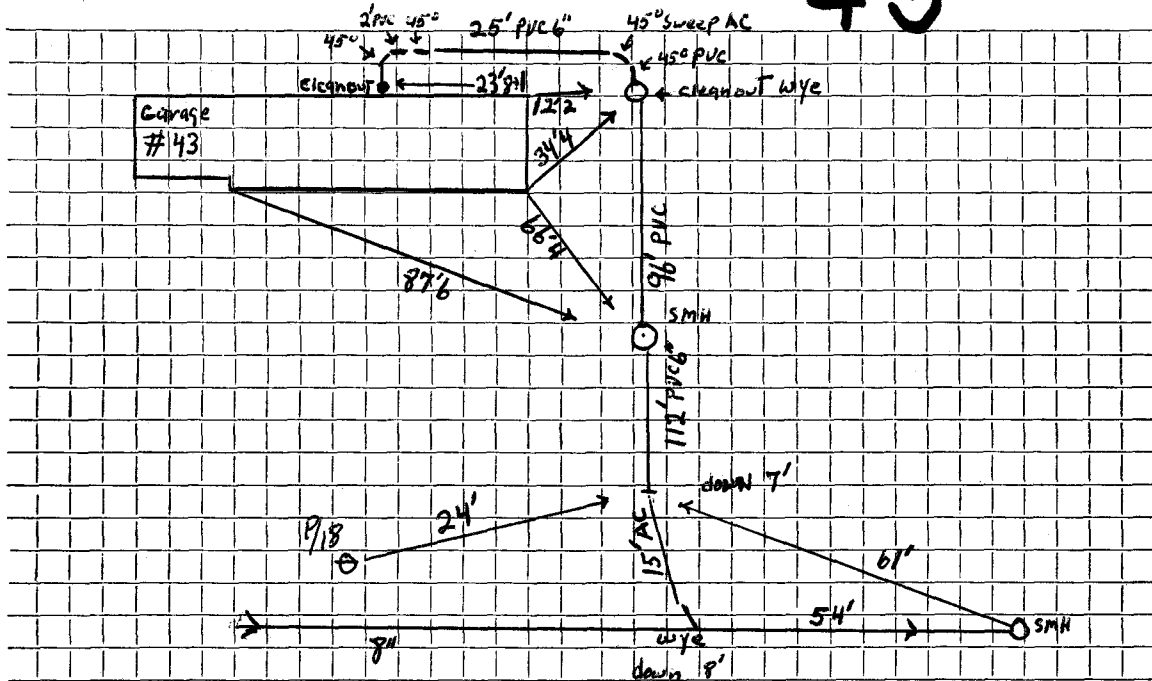

Connection made in Robinson Rd. Street. Work completed

Remarks:
.....
.....