


DATE 6/8/88

TOWN OF LEXINGTON — BOARD OF PUBLIC WORKS
SEWER DIVISION

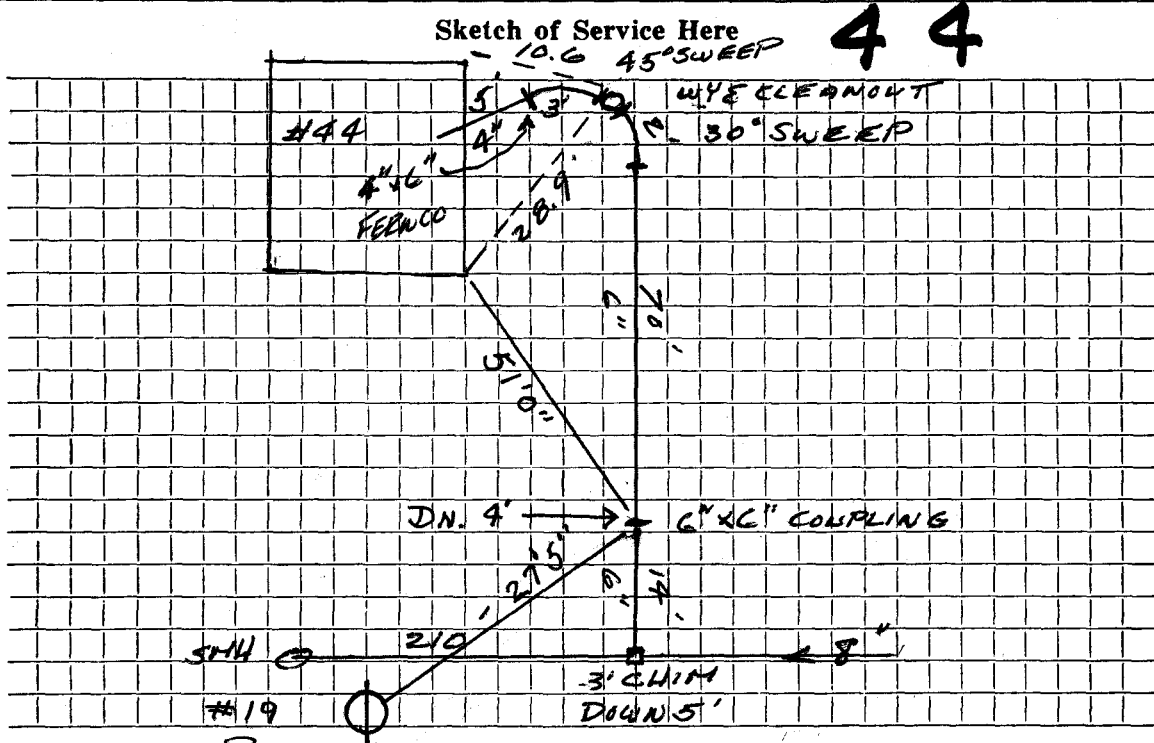


Connection made in ROBINSON RD. Street. Work completed

Remarks:

DATE APRIL 24 1998

TOWN OF LEXINGTON — BOARD OF PUBLIC WORKS
SEWER DIVISION

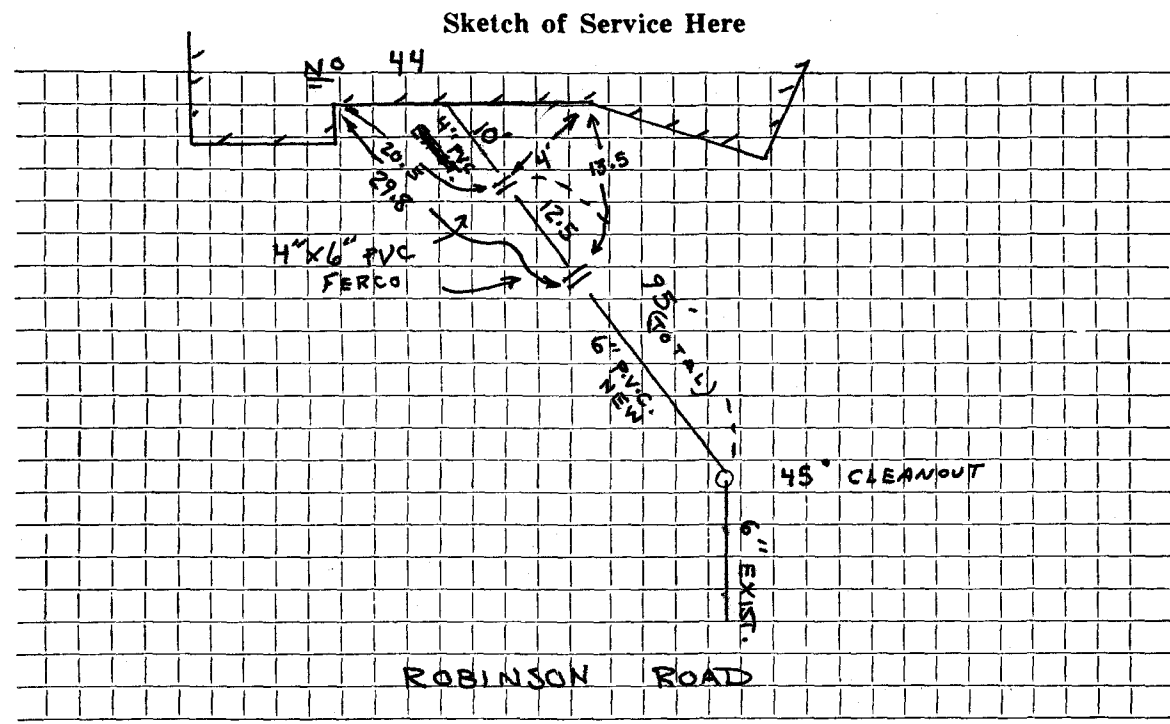

Connection made in ROBINSON ROAD..... Street. Work completed ...J. MCLAUGHLIN.....

Remarks:

.....

.....