


Sewer Service Tie Card
TOWN OF LEXINGTON
 MASSACHUSETTS

46 Robinson Road

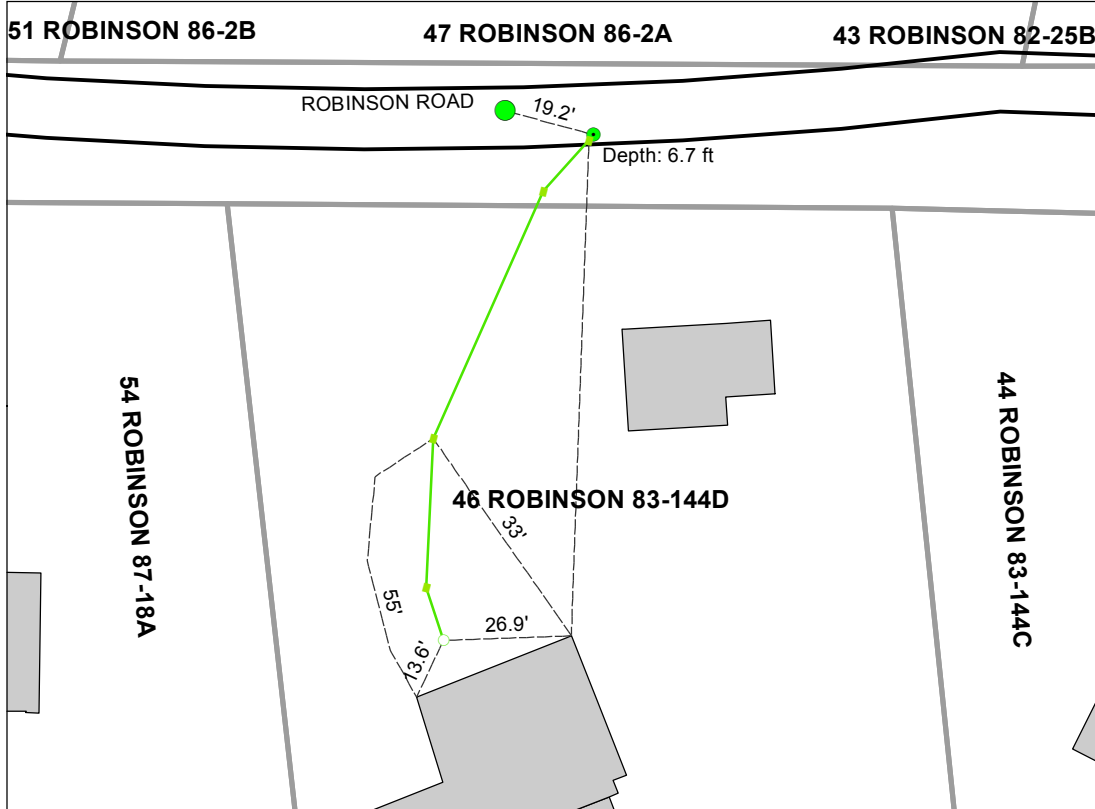

Legend

- Sewer Manholes
- Sewer Service Clean Out
- Sewer Service Bends
- Sewer Service Connection
- - - Ties_Dimensions Sewer
- Sewer Service Line

Address	Map and Lot	Contractor Name	Inspector
46 Robinson Road	83-114D	Arlex Oil	D. Pavlik

Date	Material	Amount
November 25, 2013	6x6 AC to PVC Fern Co	Connected to existing stub
	6" PVC	22 degree bend
	6" PVC	14 Feet to 22 degree bend
	6" PVC	22 degree bend
	6" PVC	56 Feet to 11 degree bend
	6" PVC	11 degree bend
	6" PVC	33.2 Feet to 11 degree bend
	6" PVC	11 degree bend
	6" PVC	10.6 Feet to Clean Out
	6"x4" Fern Co.	Fern Co. at Clean Out

Type of work completed

New 6" PVC sewer service installed to house from old sewer stub. Previously on septic - septic tank abandonment.