




DATE \_\_\_\_\_

TOWN OF LEXINGTON — BOARD OF PUBLIC WORKS  
SEWER DIVISION

Sketch of Service Here

47

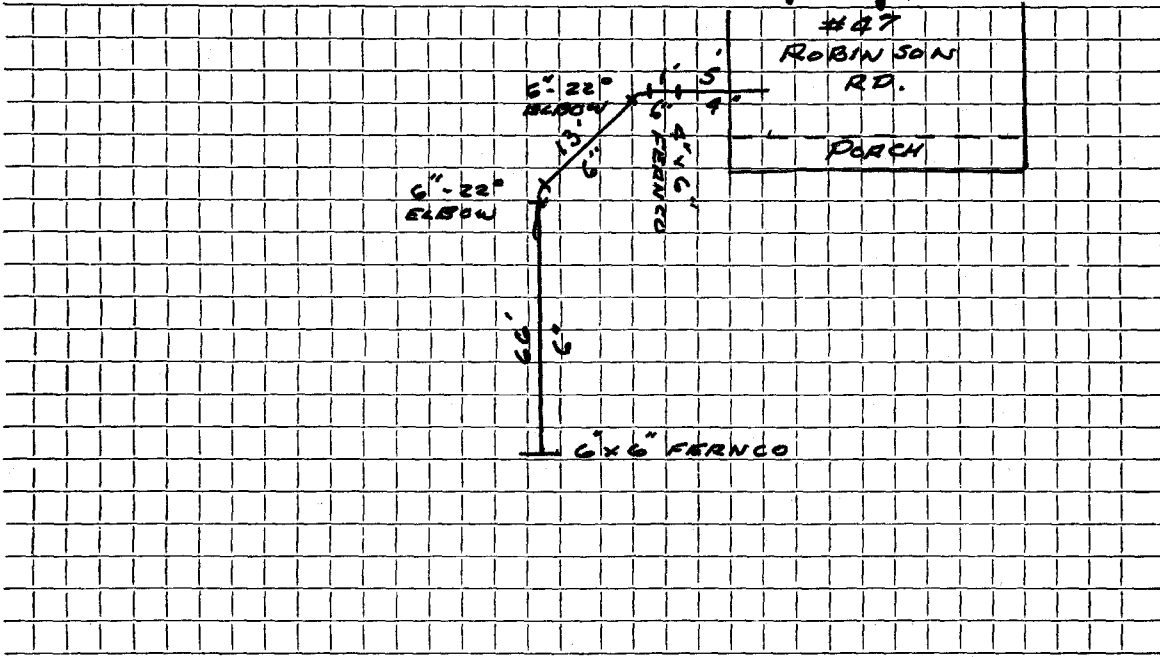

Connection made in ROBINSON RD. Street. Work completed .....

Remarks: B. MCKEE CONTR. .....

.....

.....