


DATE 30 OCTOBER 1996

TOWN OF LEXINGTON — BOARD OF PUBLIC WORKS

SEWER DIVISION

Sketch of Service Here

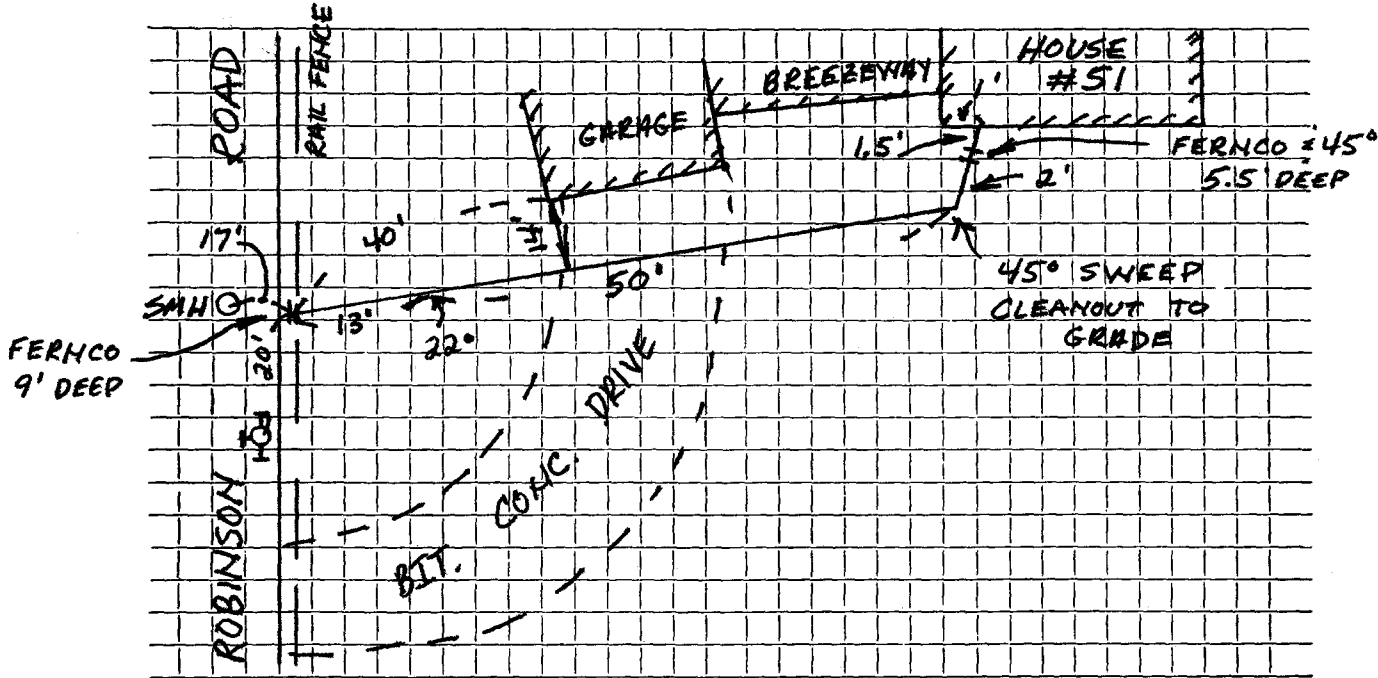

Connection made in ROBINSON ROAD Street. Work completed DAVID SAMTO

Remarks:


.....

.....

DATE 8/4/80

TOWN OF LEXINGTON — BOARD OF PUBLIC WORKS
SEWER DIVISION

Sketch of Service Here **51**

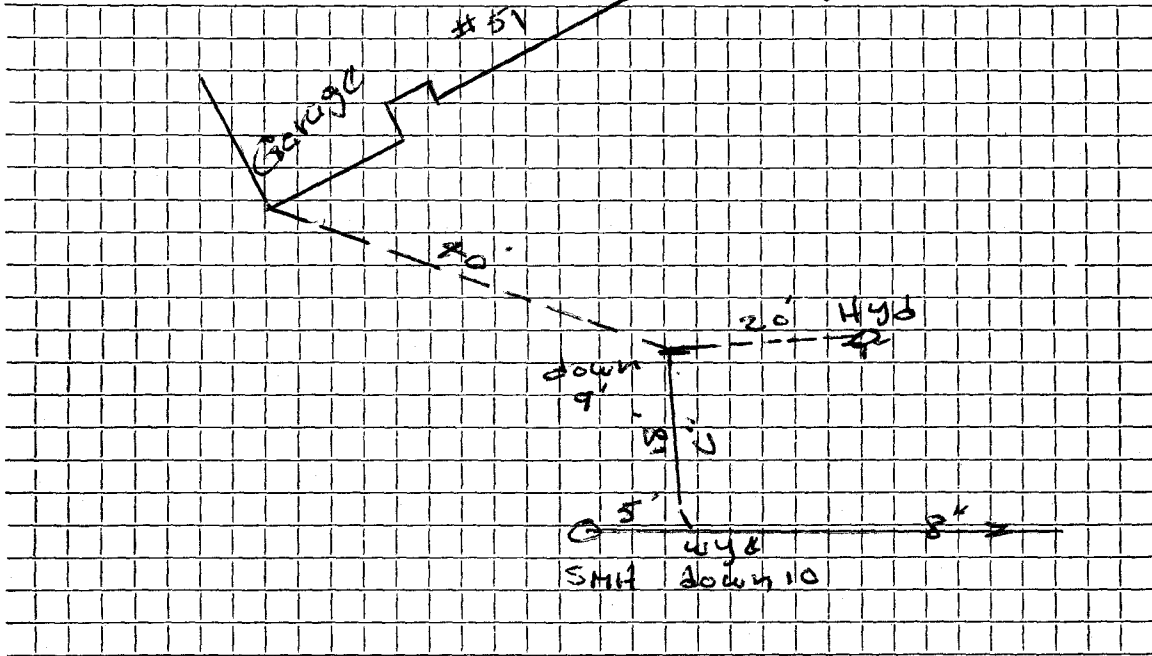

Connection made in ROBINSON RD Street. Work completed

Remarks: