


TOWN OF LEXINGTON — BOARD OF PUBLIC WORKS
SEWER DIVISION

DATE 4/12/2021

Sketch of Service Here

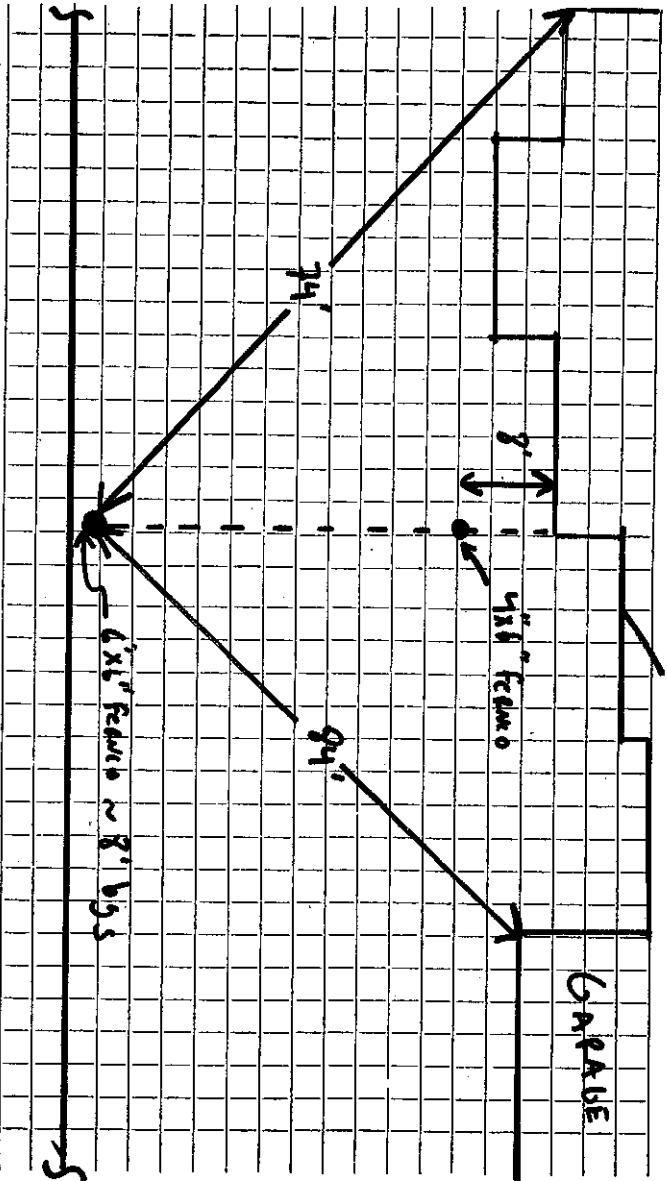

Connection made in Robinson Street. Work completed Sewer Renewal.


Remarks:

DATE 8/4/80

TOWN OF LEXINGTON — BOARD OF PUBLIC WORKS
SEWER DIVISION

Sketch of Service Here

54

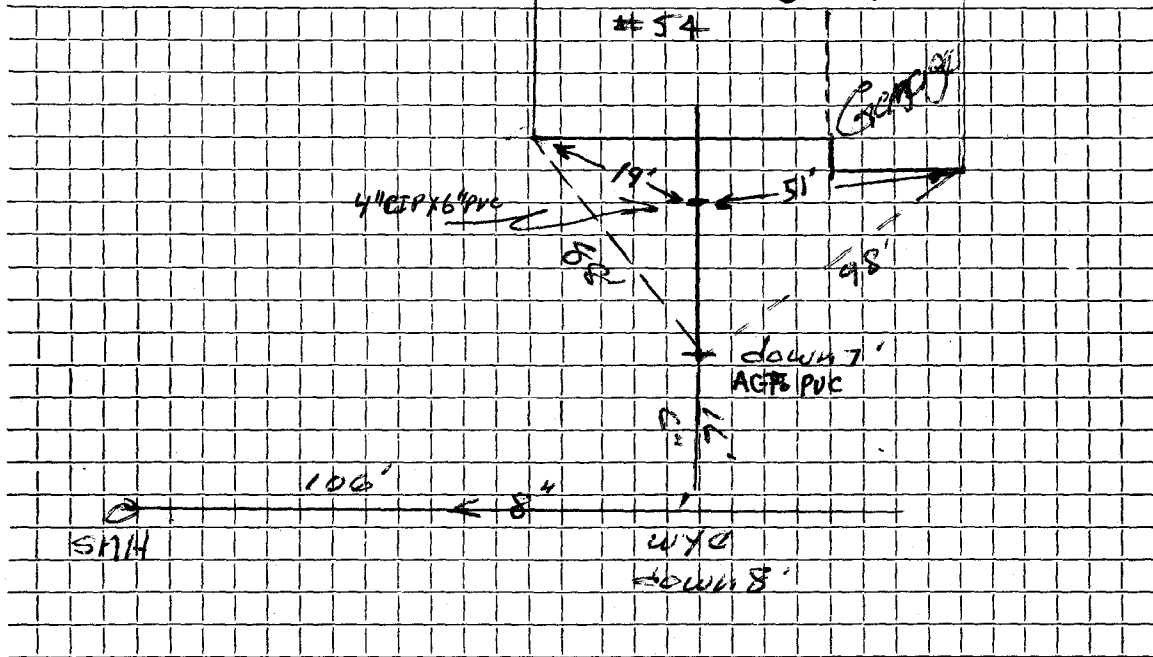

Connection made in ROBINSON RD. Street. Work completed JUNE 5, 1984

Remarks: