

Name Alan Harwood

Service No. 87

Address 8 Robinson Road

8 Robinson Road

Location

Kind of Pipe

Size 6"

Size of Main 8"

Repair—Renewal—New Service Valeri #746

Location OCT 9 1967


Date		Material	Amount	Total	Date		Amount
Jun '67	25	6" Transite pipe @7.00		175.00	7-26-67	Deposit	175 00
3-22-67	36	6" Transite pipe					
	10	4" Cast Iron pipe					

DATE _____

TOWN OF LEXINGTON — BOARD OF PUBLIC WORKS
SEWER DIVISION

Sketch of Service Here

8

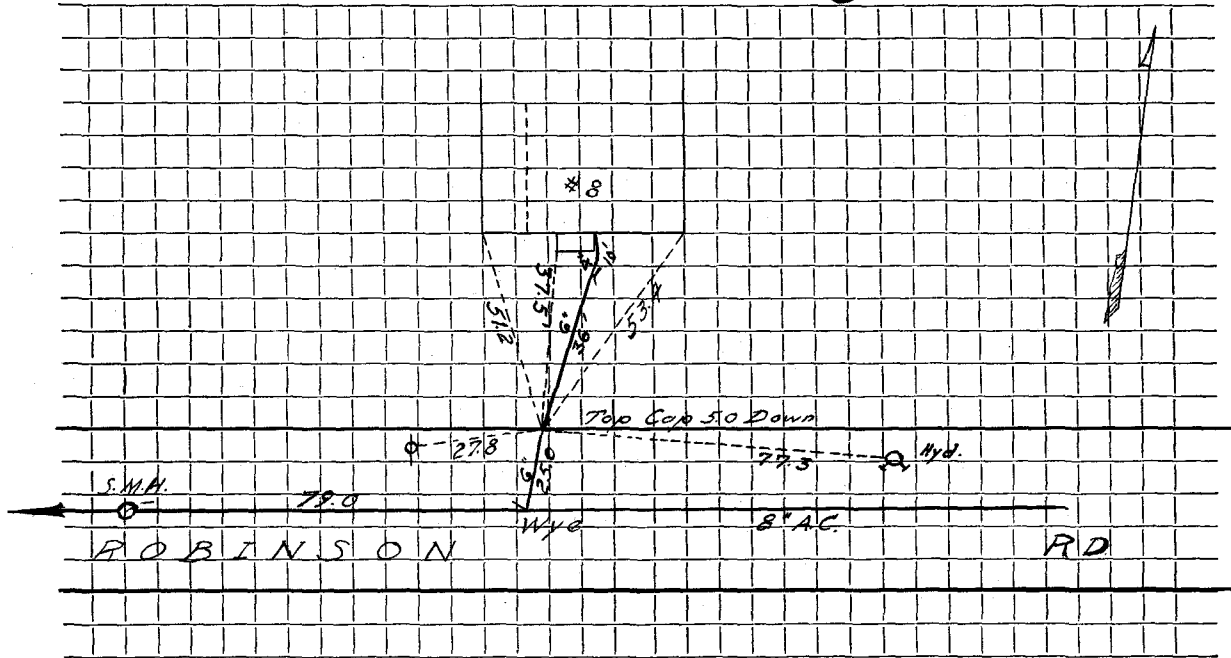

Connection made in Street. Work completed

Remarks:

.....

.....