


DATE 8/5/80

TOWN OF LEXINGTON — BOARD OF PUBLIC WORKS # JUNE 4, 1997

SEWER DIVISION

Sketch of Service Here **11**

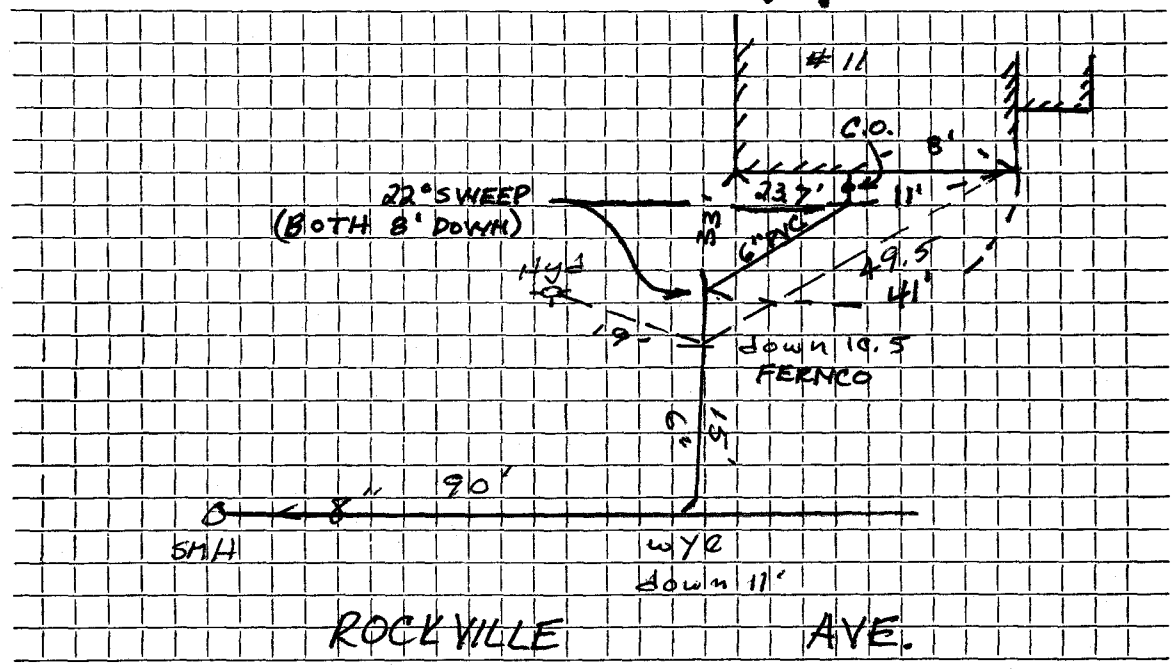

Connection made in ROCKVILLE AVE Street. Work completed

Remarks: SEWER SERVICE INSTALLED JUNE 4, 1997.