


DATE 8/5/80

TOWN OF LEXINGTON — BOARD OF PUBLIC WORKS
SEWER DIVISION

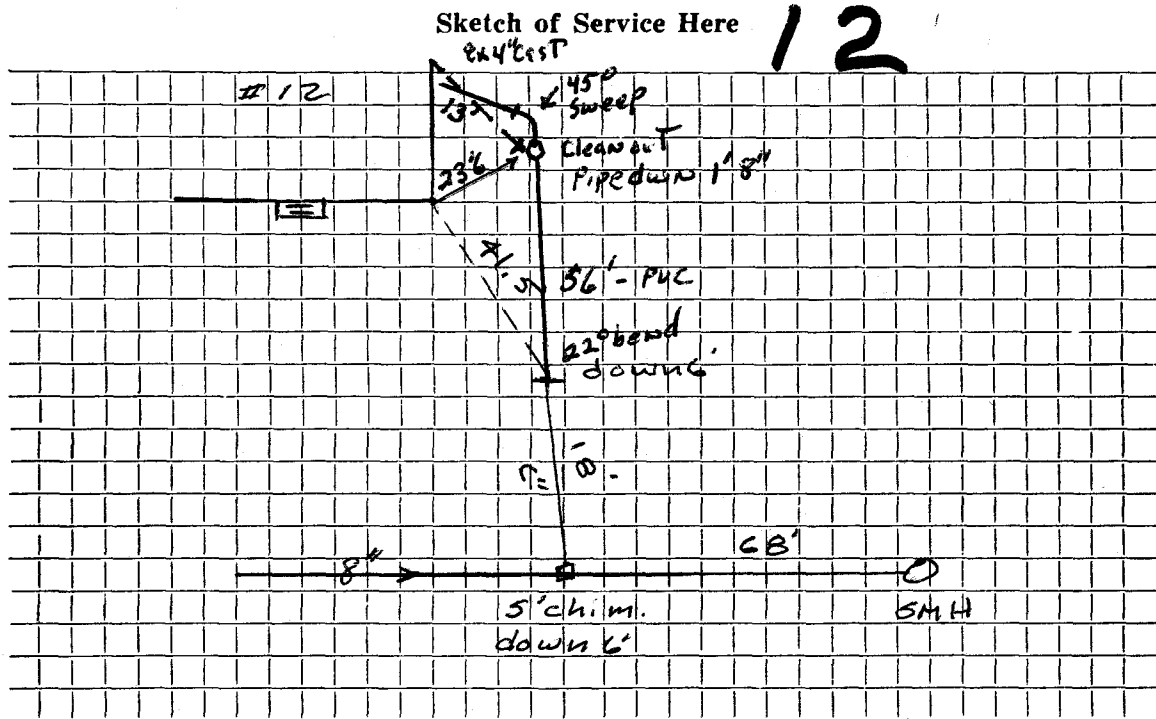

Connection made in ROCKVILLE AVE. Street. Work completed

Remarks:

.....

.....