

Name Robert D. Bradley

Service No. 44

Address 15 Rockville Avenue

15 Rockville Ave.

Location

Kind of Pipe

Size 6"

Size of Main 8"

Repair—Renewal—New Service Eagle #1878

Location AUG 14 1972


Date	Material	Amount	Total	Date	Amount
8-20-60	Labor	55.95		6-22-71	82.93
	10% O.H.	5.60	61.55	Deposit	
10'	6" Transite pipe		7.00		
1	6" Clay Elbow		1.88		
1	hr. Town Shovel @6.50		6.50		
1	hr. Trucking @3.00		3.00		
1	hr. Allis Chalmers @3.00		3.00		
1/6/71	335' 6" Transite pipe		82.93		

DATE _____

TOWN OF LEXINGTON — BOARD OF PUBLIC WORKS

SEWER DIVISION

Sketch of Service Here **15**

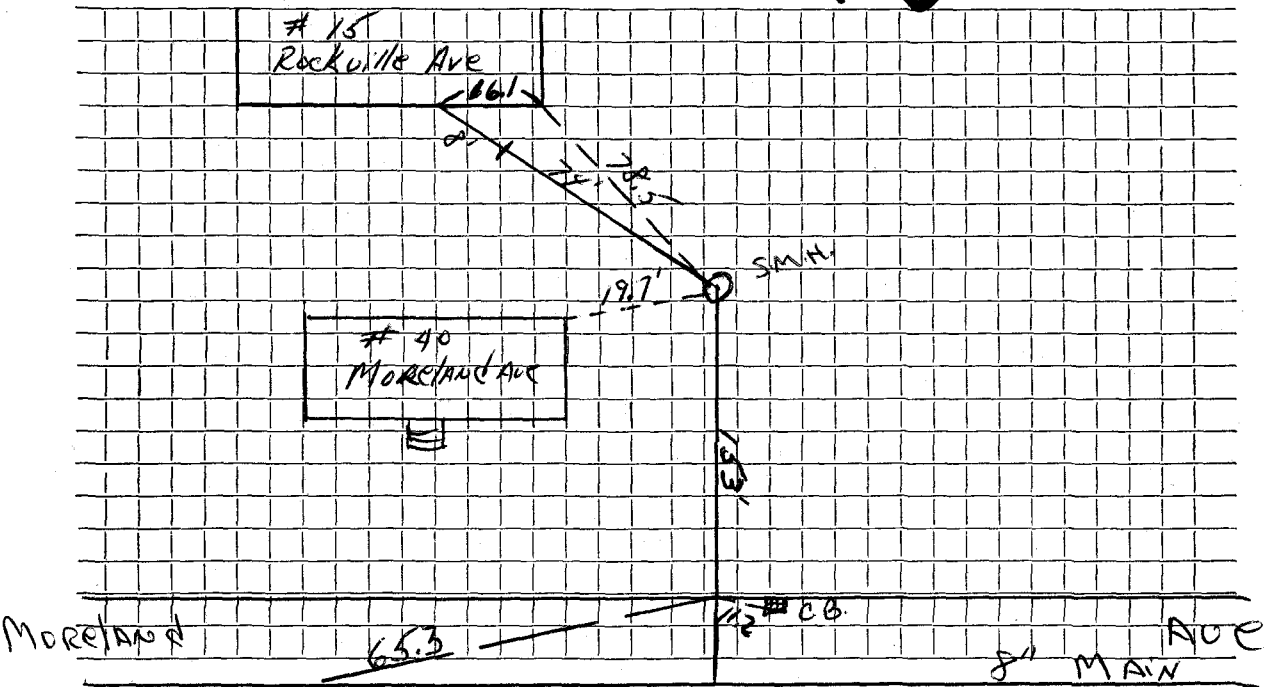

Connection made in POLE # 11 Street. Work completed

Remarks:
.....
.....