


DATE 8/5/80

TOWN OF LEXINGTON — BOARD OF PUBLIC WORKS

SEWER DIVISION

Sketch of Service Here **26**

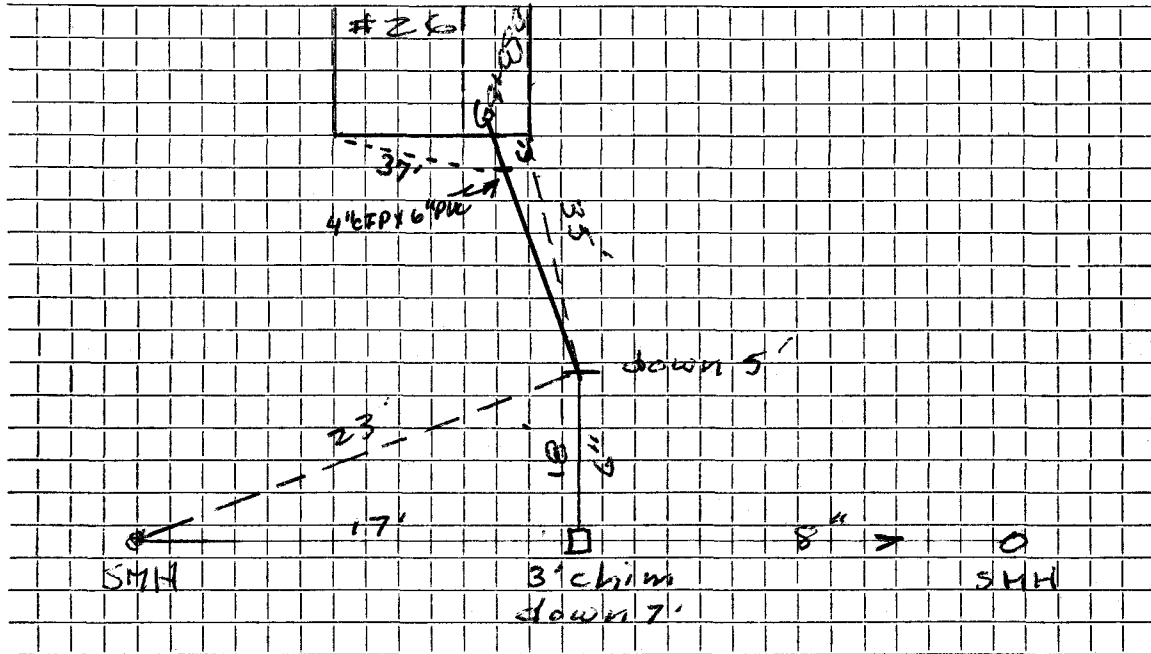

Connection made in ROCKVILLE AVE, Street. Work completed Nov 1985

Remarks: