




DATE \_\_\_\_\_

TOWN OF LEXINGTON — BOARD OF PUBLIC WORKS

SEWER DIVISION

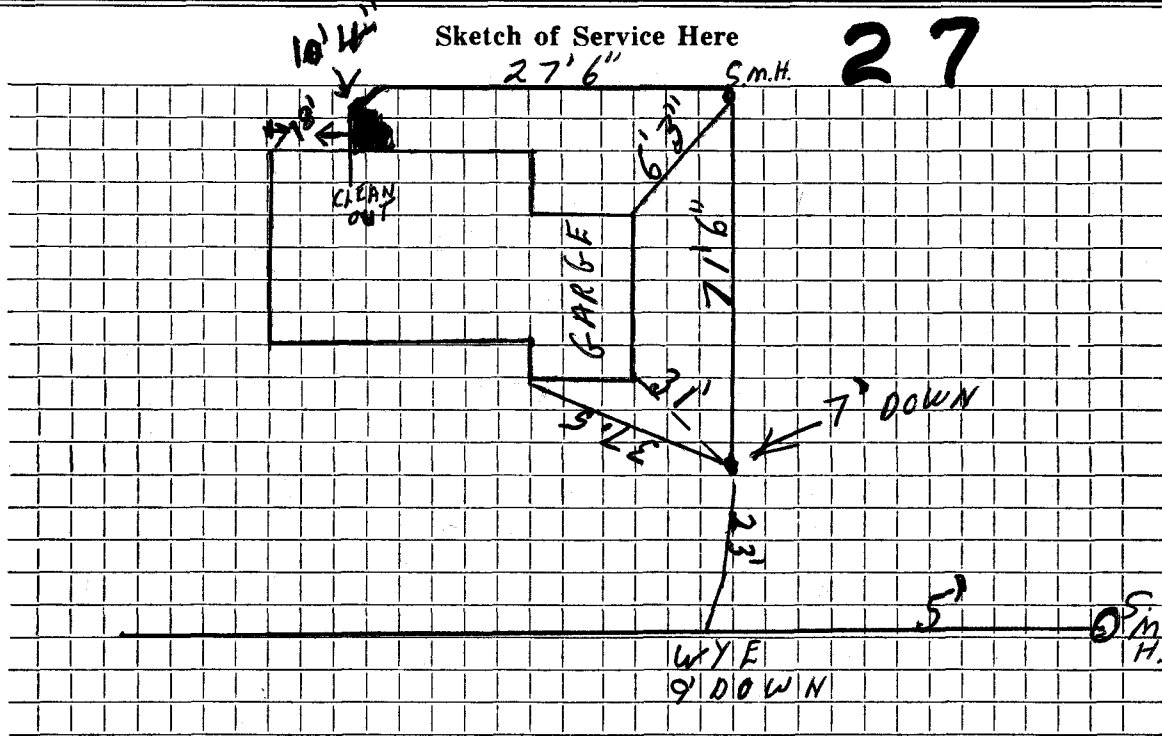

Connection made in 27 ROCKVILLE AVE Street. Work completed .....

Remarks: .....

.....

.....