

Name

Service No.

Address

30 Rockville Ave

Location

Kind of Pipe

SDR35 PVC

Size

6"

Size of Main

Repair

Renewal

New Service

Location

Date

Material

Amount

Total

Date

Amount

10/28/01

6" Cleanout


6" PVC SDR35

40'

6x6" fence

TOWN OF LEXINGTON — BOARD OF PUBLIC WORKS
SEWER DIVISION

Sketch of Service Here

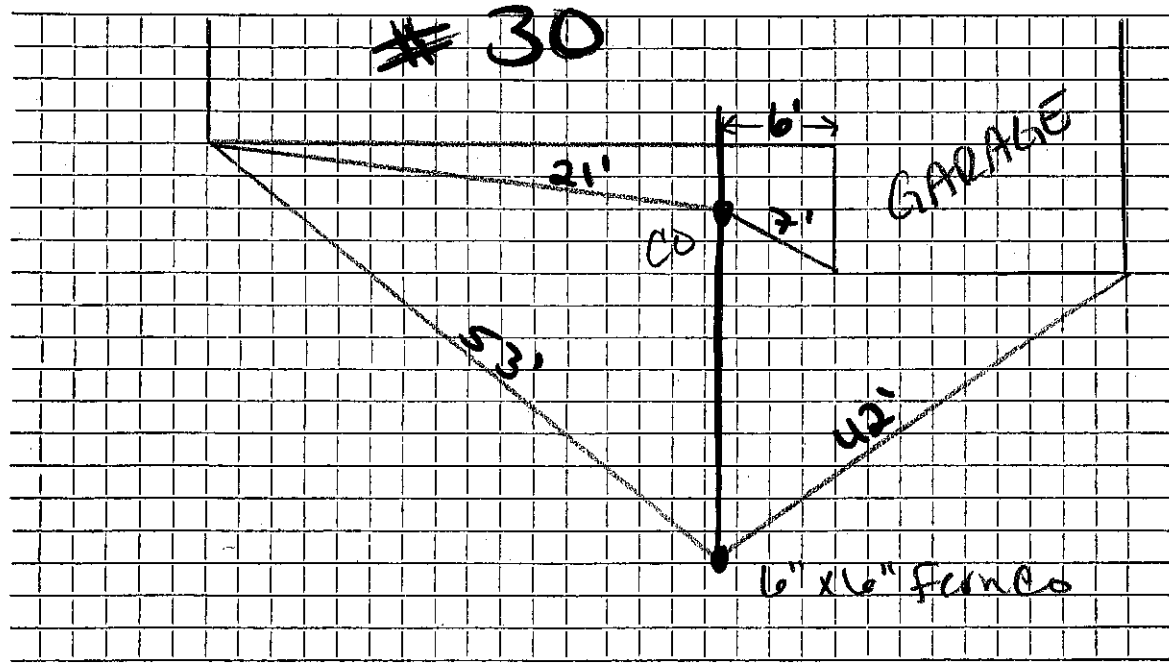

Connection made in ... Rockville Ave ... Street.

Work completed

Remarks: