

Name Oscar W. Carlson

Service No. 91

Address 34 Rockville Avenue

34 Rockville Ave.

Location

Kind of Pipe

Size 6"

Size of Main 8"

Repair - Renewal - New Service Cont. Dave Eagle W.O. #7438

Location

JAN 27 1969


Date	Material	Amount	Total	Date	Amount
10/8/68	Labor	30 40		9-30-68	370 00
10/9/68	"	110 80	141 20	1-31-69	61 33
	10% O.H.		14 12		208 78
	20' Transitepipe .88		17 60		
	1 90° Elbow		4 09		
	2 12" Nipple 1.21		2 42		
	1 22½ Elbow		2 35		
	1 Hr. Shovel		6 50		
	5 " Trucking 3.00		15 00		
	½ " Loader 4.00		2 00		
	½ " Roller 3.00		1 50		
	Trailer		2 00		
10-29-68	26' 6" Transite pipe		208 78		
	10' 4" Cast Iron pipe				

Deposit
Retained

DATE _____

TOWN OF LEXINGTON — BOARD OF PUBLIC WORKS
SEWER DIVISION

Sketch of Service Here **34**

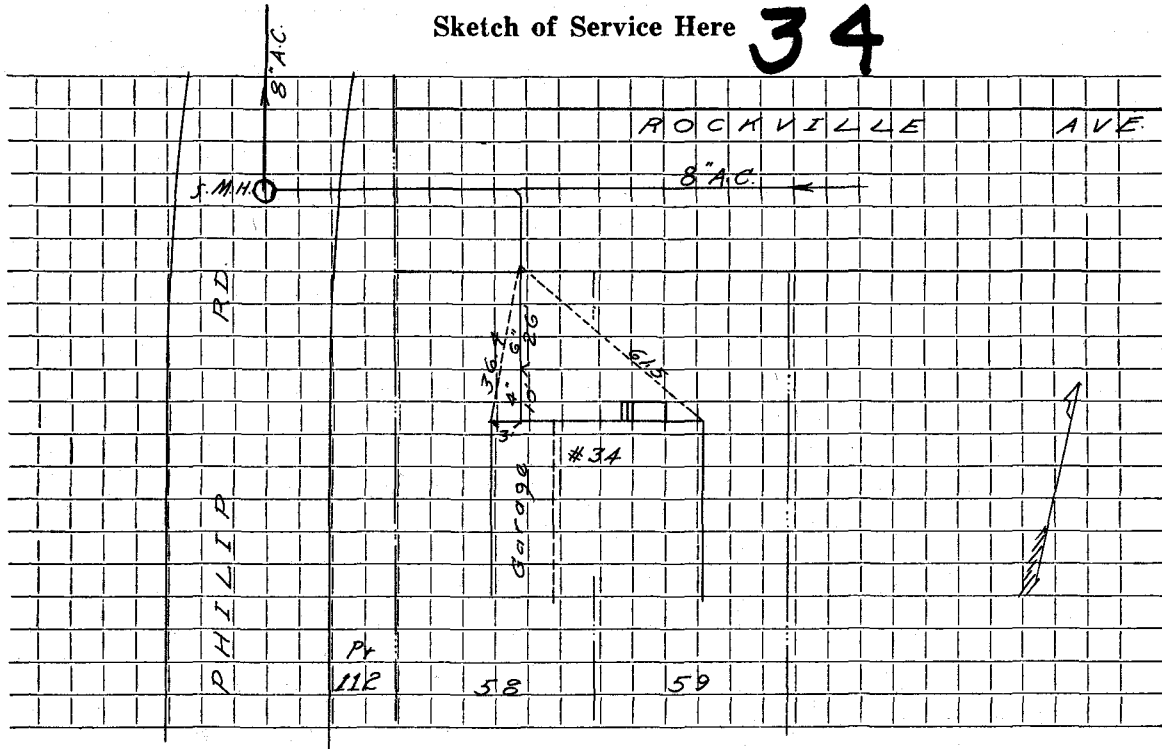

Connection made in Street. Work completed

Remarks:
.....
.....