


DATE 10/26/95

TOWN OF LEXINGTON — BOARD OF PUBLIC WORKS
SEWER DIVISION

Sketch of Service Here **7**

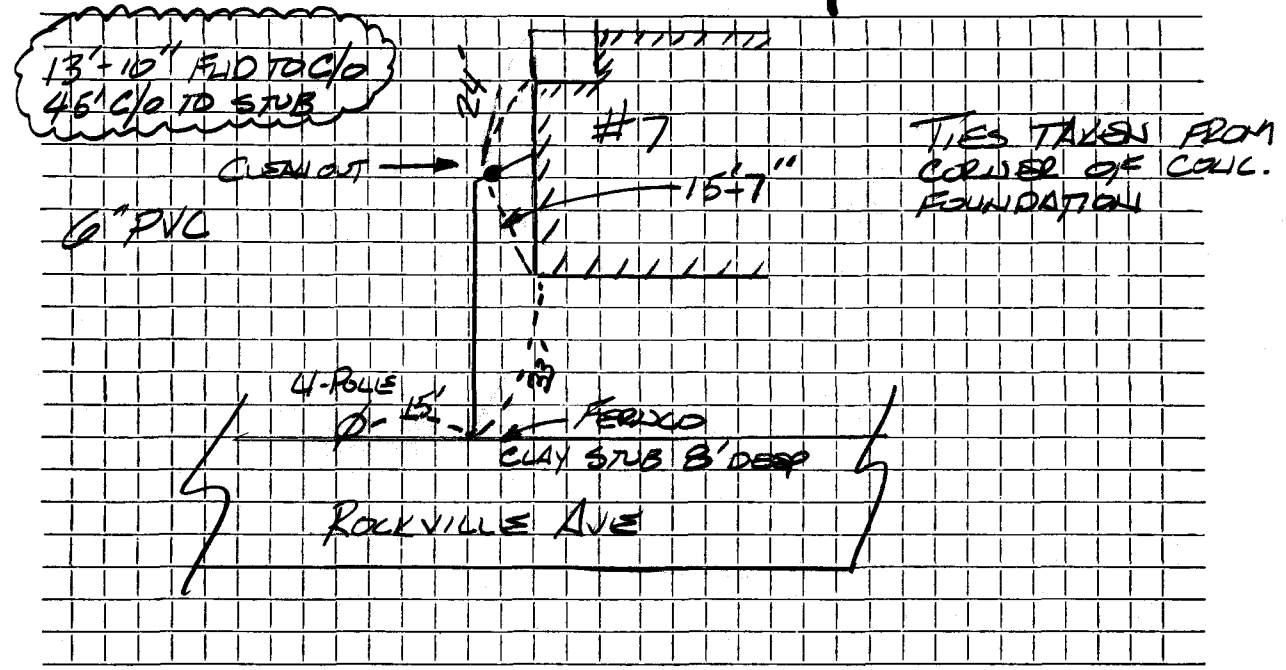

Connection made in ROCKVILLE AVE Street. Work completed

Remarks: CONTRACTOR PAUL ROSE

INSPECTED JFH