

Name

Service No.

Address 2 Rogers Road

Lot #9

Location

Kind of Pipe

Size 6"

Size of Main 8"


Repair—Renewal—New Service

Location

Date		Material	Amount	Total	Date	Amount
1971	28'	6" Transite pipe @7.50		210.00		

TOWN OF LEXINGTON — BOARD OF PUBLIC WORKS
SEWER DIVISION

Sketch of Service Here **2**

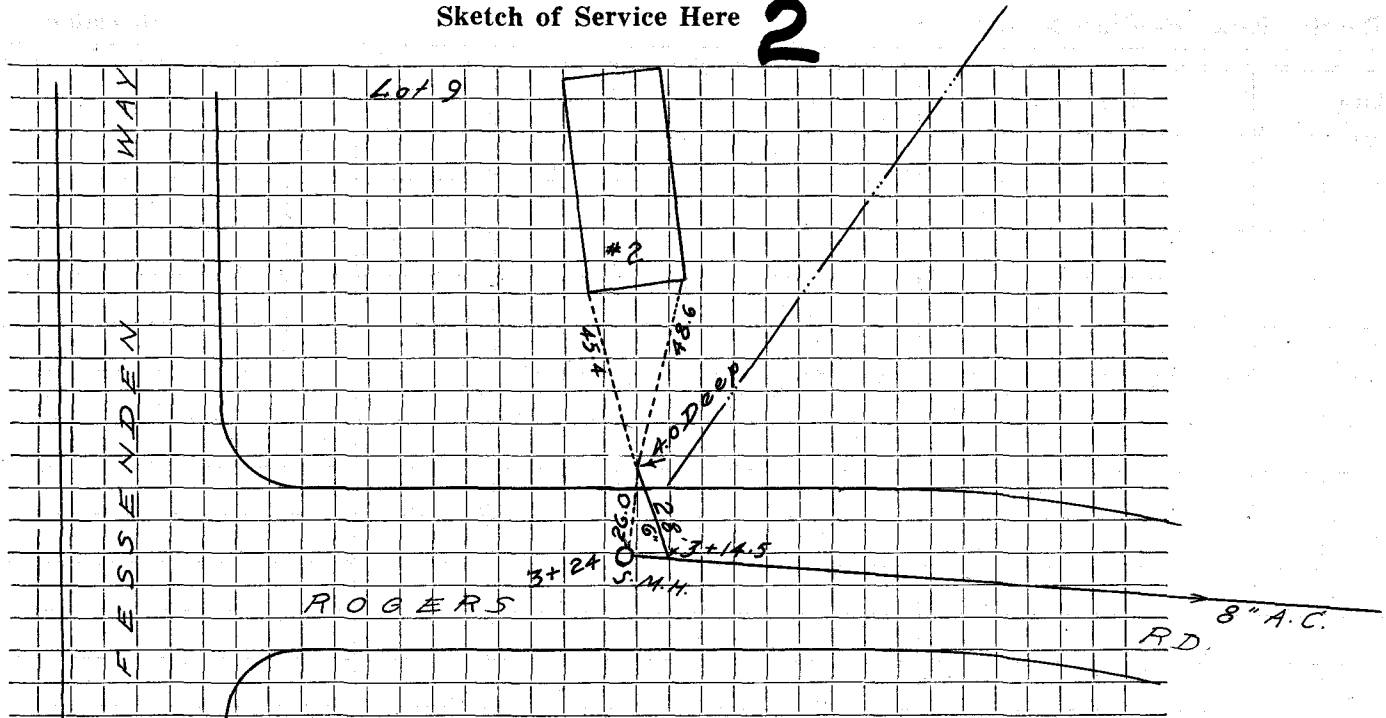

Connection made in Street. Work completed

Remarks:

.....

.....