




TOWN OF LEXINGTON — BOARD OF PUBLIC WORKS

SEWER DIVISION

Lot 11A

Sketch of Service Here

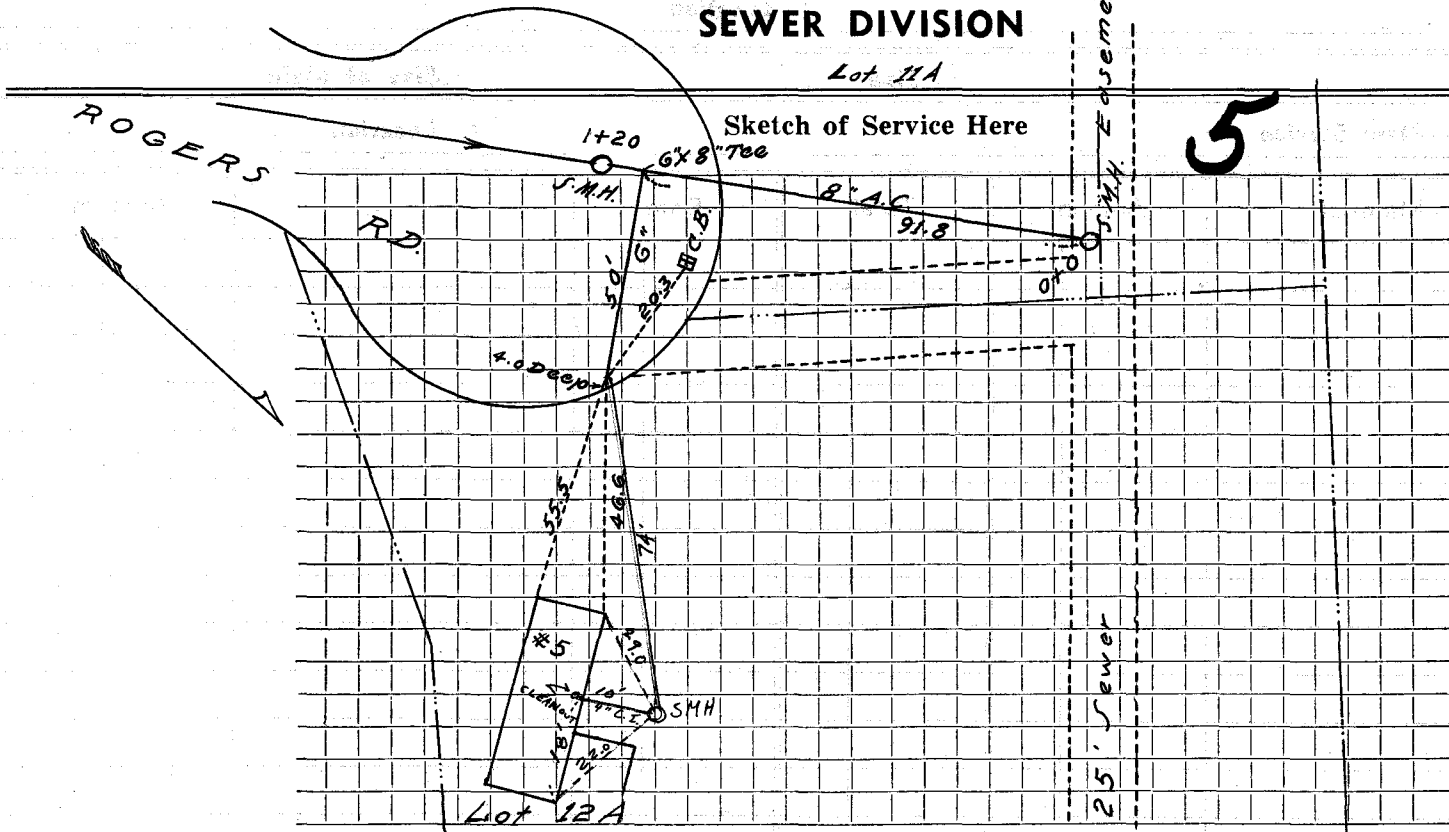

Connection made in ..... Street. Work completed .....

Remarks: 2/15/95. PIPE BROKEN UNDER WATER MAIN NEAR HYD GATE. ....