

Name

Service No.

Address **6 ROLPK**

UTICON

Location

Kind of Pipe

Size

Size of Main

Repair ~~Renewal~~ New Service

Location

Date

Material

Amount

Total

Date

Amount

5/2017

6" SDR

6" CLEAN OUT

6" CAP

6" TEE WYE


6" SDR RISER

6" 6 FERNCO

DATE 5/10/2017

TOWN OF LEXINGTON — BOARD OF PUBLIC WORKS
SEWER DIVISION

Sketch of Service Here

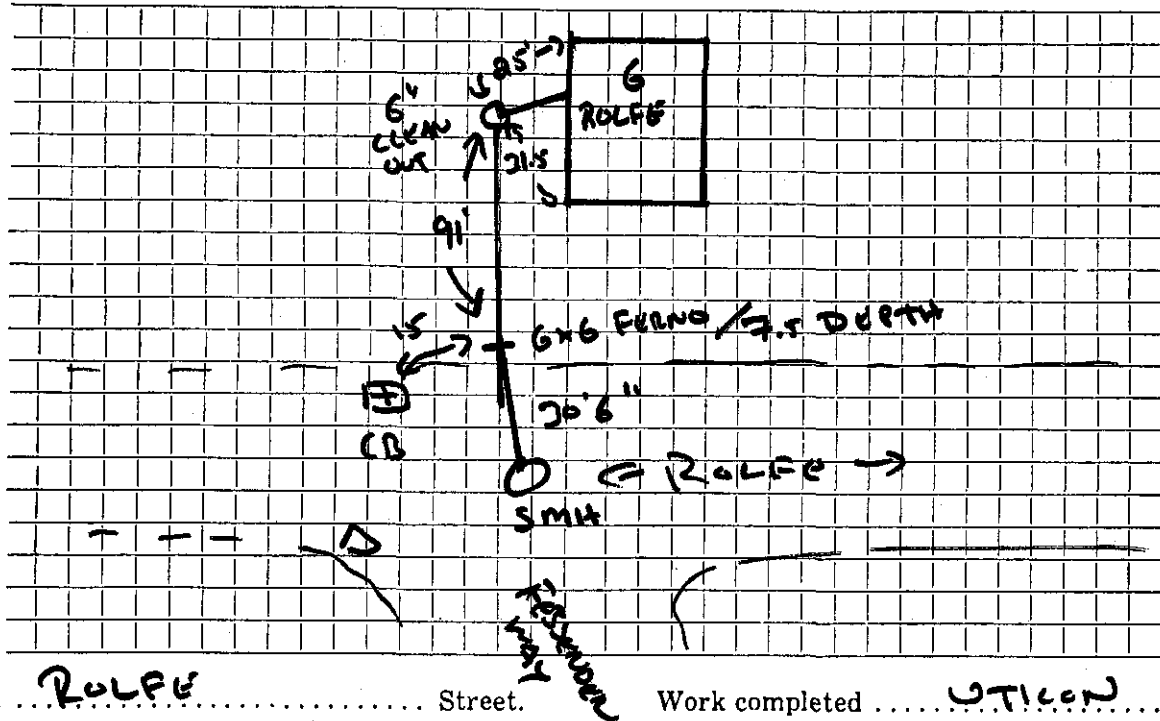

Connection made in ROLFE Street. Work completed in UTICON

Remarks:

.....

.....