

Name

Service No.

Address *10 Rolfe Road*

10 ROLFE Road

Location

Kind of Pipe

Size *6"*

Size of Main *8"*

Repair—Renewal—New Service *Eagle #2756*

Location


Date		Material	Amount	Total	Date		Amount
0/17/75	69'	6" Transite pipe					
	10'	4" Cast Iron pipe					
					7-2-	75	
						4' 6" Transite	
						1 6" X 8" Wye	

DATE _____

TOWN OF LEXINGTON — BOARD OF PUBLIC WORKS

SEWER DIVISION

Sketch of Service Here **10**

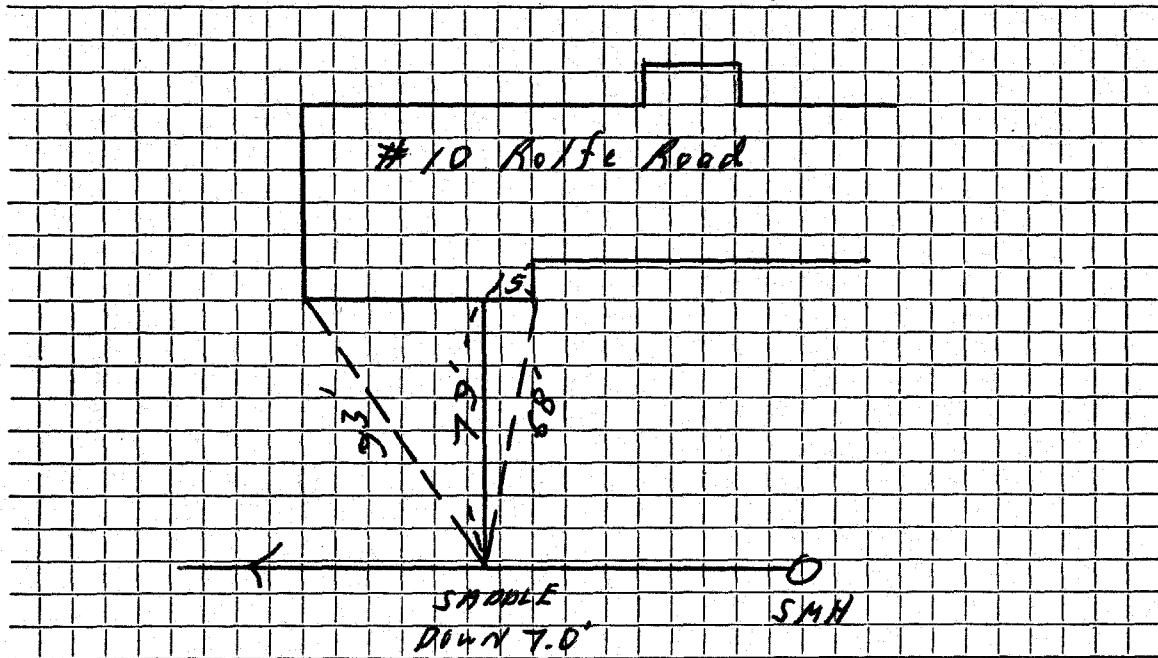

Connection made in Rolfe Road ~~Street~~ Work completed

Remarks:

.....

.....