

Name Anton S. Morton

Service No. 89

Address 3 Rolfe Road

Lot 29

Location

Kind of Pipe

Size 6"

Size of Main 8"

Repair—Renewal—New Service

Eagle # 1931

Location JUN 5 1972


Date		Material	Amount	Total	Date	Amount
1971	5'	76" Transite pipe @7.50		112.50	11-26-71	112.50
11/26/71	35'	6" Transite pipe				
	10'	4" Cas t Iron				

*Deposit*

TOWN OF LEXINGTON — BOARD OF PUBLIC WORKS

SEWER DIVISION

Sketch of Service Here **3**

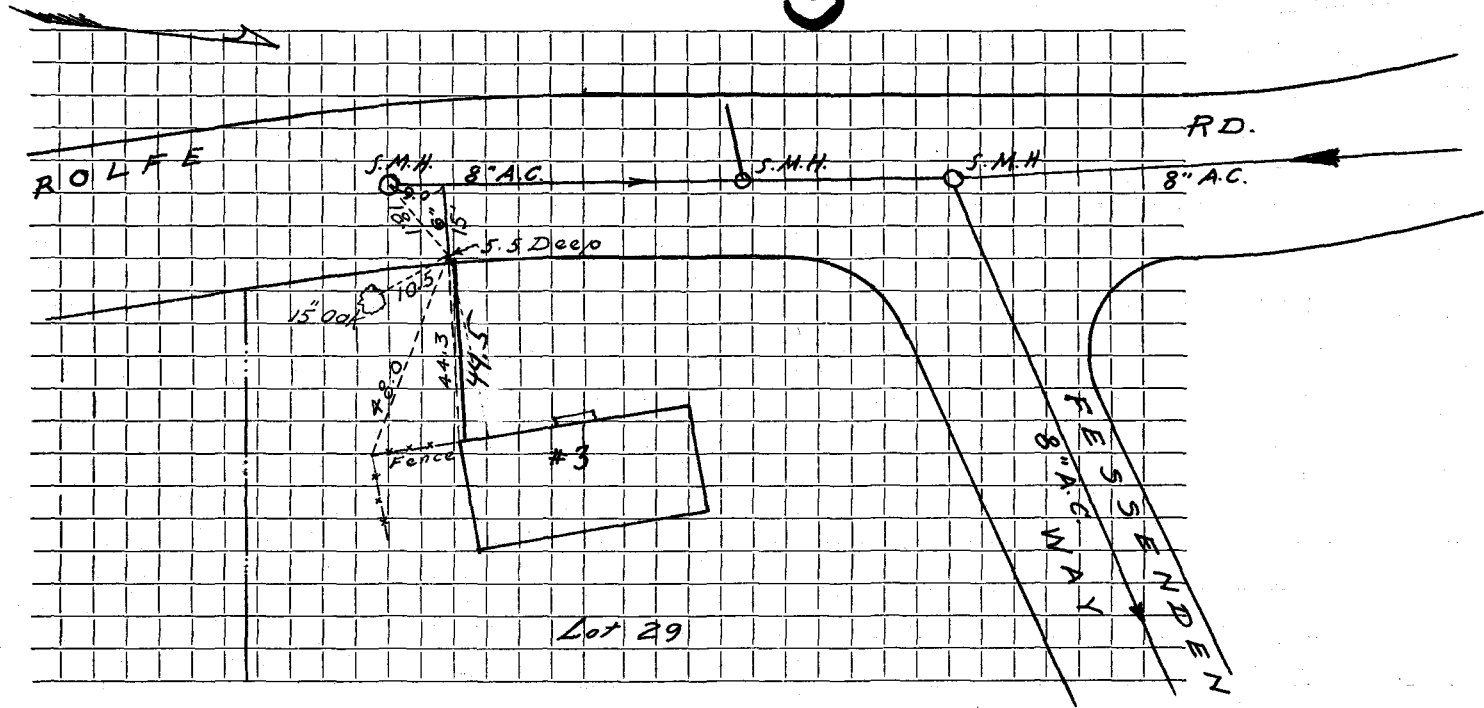

Connection made in ..... Street. Work completed .....

Remarks: .....  
.....  
.....