

Name

Service No.

Address 9 Rolfe Road

9 ROLFE ROAD

Kind of Pipe

Size 6"

Size of Main 8"

Repair—Renewal—New Service Eagle #2755

Location

Location


Date	Material	Amount	Total	Date	Amount
10/17/75	110' 6" Transit pipe				
10'	4" Cast Iron pipe			7-3-75	
				4' 6" Transit	
				1 6" X 8" Wye	

DATE _____

TOWN OF LEXINGTON — BOARD OF PUBLIC WORKS
SEWER DIVISION

Sketch of Service Here

9

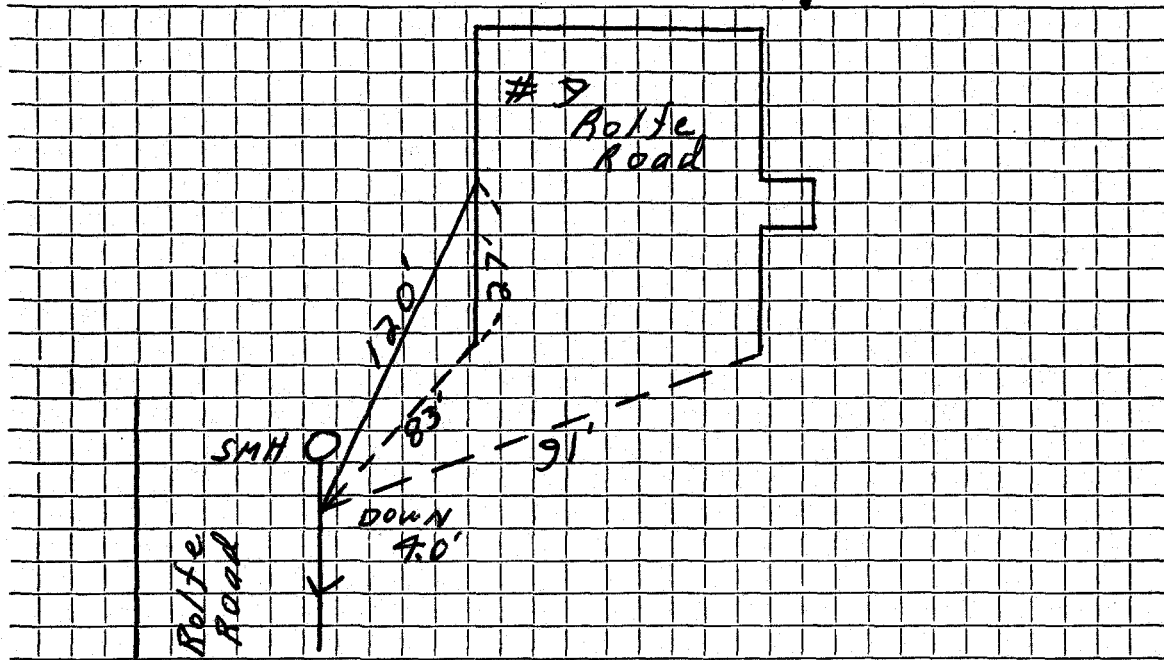

Connection made in Rolfe Road..... Street: Work completed

Remarks:

.....

.....