

Name

Service No.

Address 2 ROLLING LN

MCLAUGHLIN

Location

Kind of Pipe

Size

Size of Main

Repair—Renewal—New Service

Location

Date

Material

Amount

Total

Date

Amount

5/15/17

6" SDR

6" CLEAN OUT

• 6" PVC CAP

• 6" SDR


• 6" TEE W/CF

6' x 6" FERNICO

DATE 8/15/17

TOWN OF LEXINGTON — BOARD OF PUBLIC WORKS
SEWER DIVISION

Sketch of Service Here

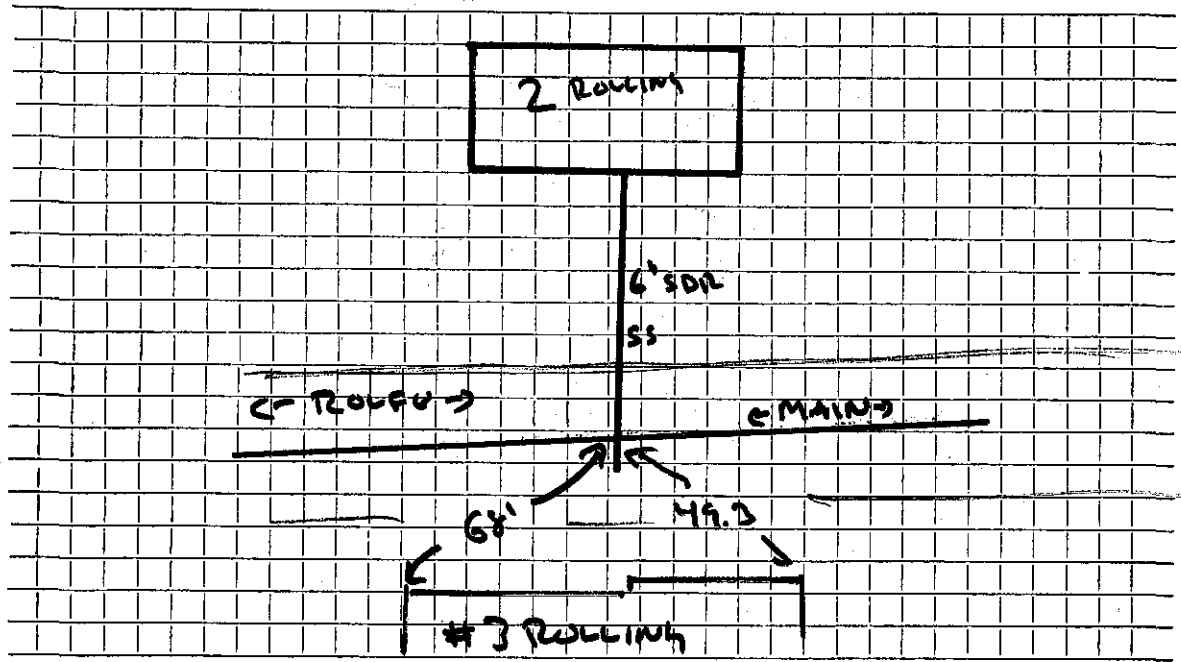

Connection made in Rolling Street. Work completed McLAUGHLIN

Remarks: SERVICE FOR #2 ROLLING