

Name Eric G. Sahlberg

Service No. 99

Address ~~10 Robbins Avenue~~ 7 Rolling Lane

7 Rolling Lane

Location

Comm. 9/30/57

Kind of Pipe

Size 6"

Size of Main 8"

~~Repair~~—Renewal—New Service

Location

Date	Material	Amount	Total	Date	Amount	
8/12/57	Labor	10 47		7-31-57	Deposit	\$ 150 00
8/13/57	"	32 91		9-30-57	Refund	20 98
		43 38				\$ 129 02
	10% overhead	4 34	47 72			
	59' - Transite Pipe @ .70		48 30			
	3 hrs. Town Shovel @ 6.50		19 50			
	2 hrs. Trucking @ .75		1 50			
	12x3 Patch		12 00			
			129 02			
	Labor					

TOWN OF LEXINGTON—DEPT. OF PUBLIC WORKS

SEWER DIVISION

DATE.....

NO.

The undersigned applies for the construction of a particular sewer connecting No.....
Street and hereby agrees to comply with the Rules and Regulations governing the construction and use of Particular
Sewers, as now or at any future time established by the Board of Selectmen.


Am't of estimate \$.....

Am't Paid \$.....

..... Owner

Sketch of Service Here

7

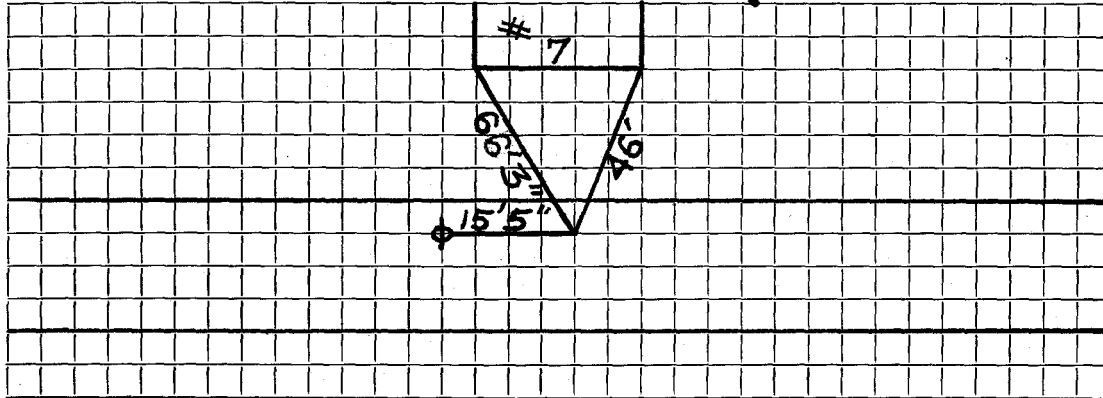

Connection made in..... Street.

Work completed.....19..

Remarks: