

Name Charles Cadario

Service No. 26

Address 29 Roosevelt Rd.

29 Roosevelt Road

Location

Kind of Pipe

Size 6"

Size of Main 8"

~~Repair-Removal~~—New ServiceLocation *Camin 5-9-60*


Date	Material	Amount	Total	Date	Amount
	20' 6" Transite pipe @3.50			4-4-60	200 00
	installed by cont.		70 00	5-9-60	16 47
					133 53
4-12-60	Labor	29. 21			
	10 % O.H.	<u>2. 92</u>	32. 13		
	30' 6" Transite Pipe @.78		23. 10		
	1 Hr. Insley Shovel @ 6.50		6. 50		
	2 Hrs. Trucking @ .75		<u>1. 50</u>		
			133.53		

DATE _____

TOWN OF LEXINGTON — BOARD OF PUBLIC WORKS

SEWER DIVISION

Sketch of Service Here **29**

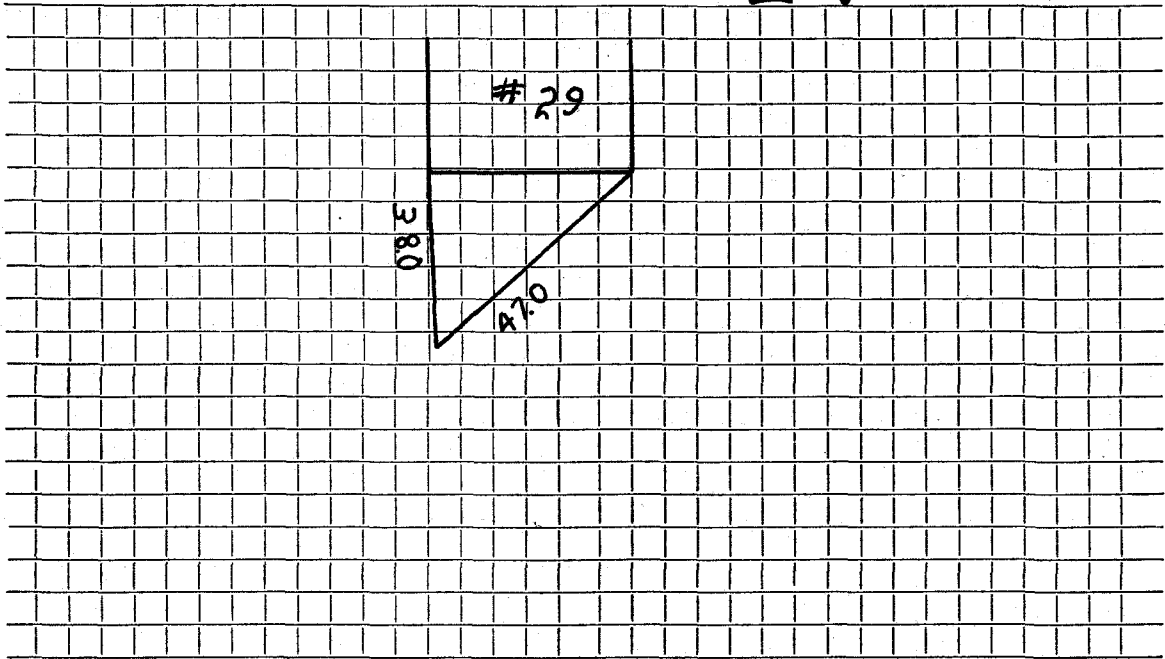

Connection made in Roosevelt R2 Street. Work completed

Remarks:
.....
.....