

Name Leighton S. Foster

Service No. #38

Address 30 Roosevelt Rd.

30 Roosevelt Road

Location

Kind of Pipe

Size 6"

Size of Main 8"

~~Repair/Alter~~ New Service WO #7191

Location Comm 6-25-62


Date	Material	Amount	Total	Date	Amount
	20' 6" Transite pipe @3.50			4-30-62	Deposit 250 00
	installed by cont.		70 00	6-25-62	Refund 37 60
5-10-62	Labor	77.05			212 40
	10% O.H.	7.71	84.76		
	38' 6" Transite Pipe @.78		29.64		
	4 Hrs. Town Shovel @5.50		22.00		
	2 Hrs. Trucking @3.00		6.00		
			212.40		

DATE _____

TOWN OF LEXINGTON — BOARD OF PUBLIC WORKS

SEWER DIVISION

Sketch of Service Here **30**

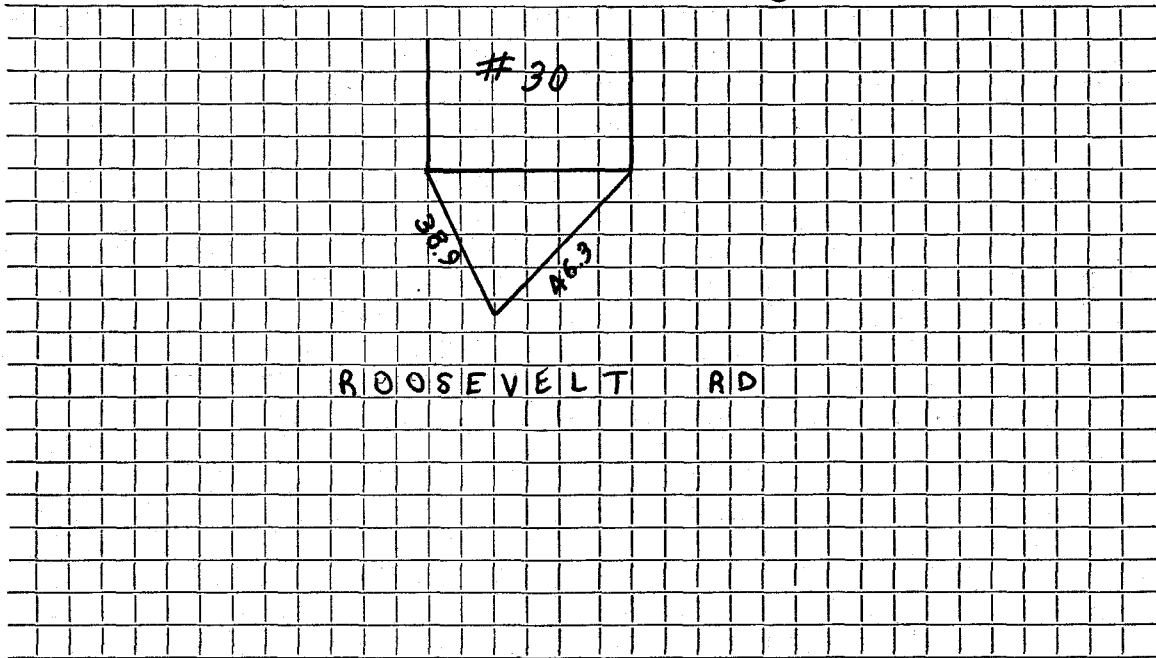

Connection made in Street. Work completed

Remarks:
.....
.....