




DATE \_\_\_\_\_

TOWN OF LEXINGTON — BOARD OF PUBLIC WORKS  
SEWER DIVISION

Sketch of Service Here **7**

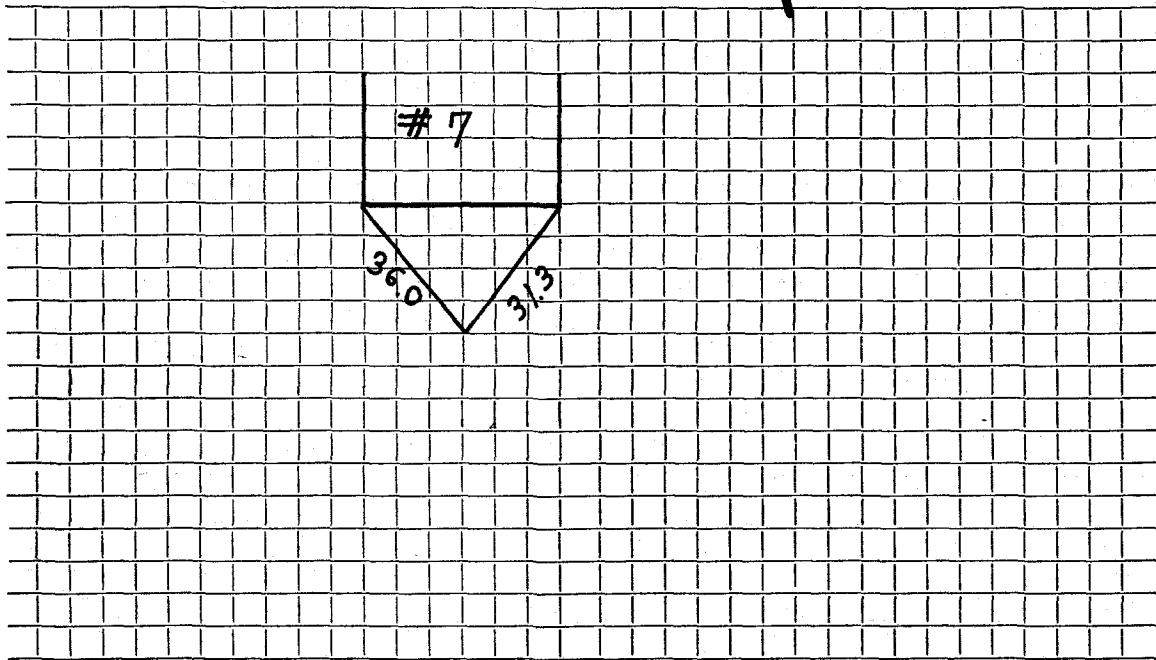

Connection made in Roosevelt Rd ..... ~~Street~~ ..... Work completed .....

Remarks: .....  
.....  
.....