

Name

Service No.

Address 11 Ross Road

11 Ross Road

Location

Kind of Pipe

Size 6"

Size of Main 8"

Repair—Renewal—New Service Valeri

Location


Date		Material	Amount	Total	Date	Amount
8/7/58	40'	6" Transite				
	1	6" Clay Tee				
11/25/58	35'	6" Transite				
	2	1 1/4" Transite Elbows				
	5'	4" Cast Iron				
10/24/85	40'	6" PVC				
	1	Fernco				
	1	AC to PVC Adaptor				
		REPAIR W.O. #1438				
10-29-85	3	6" AC TO PVC FERNGO				
	1	6" TEE PVC			XXXXXXXXXX	XXXXXXXXXXXXXXXXXX
	12'9"	6" PVC PIPE				
	8'3"	12" Drain Cement Pipe				
	14	yds. Gravel				
	2	yds. Crushed Tone				

DATE _____

TOWN OF LEXINGTON — BOARD OF PUBLIC WORKS

SEWER DIVISION

Sketch of Service Here
11 Ross Rd

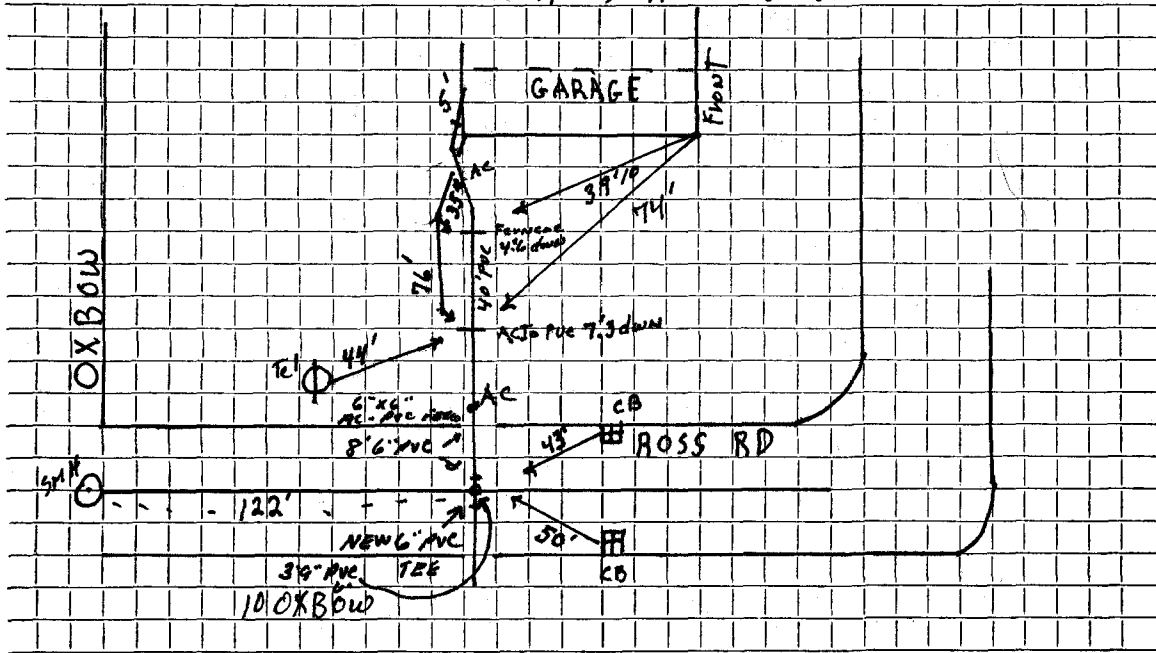

Connection made in Ross Street. Work completed

Remarks: Chimney with Tee for 11 Ross & 10 OXBOW. WASTE Service is on top off Sewer 11 Ross rd