

Name Leeland Construction

Service No. 42

Address 4 Ross Road

4 Ross Road

Location Lot 78

Comm 10-14-58

Kind of Pipe

Size 6"

Size of Main 8"

~~Repair/Replacement~~ New Service

Location

Date	Material	Amount	Total	Date	Amount
5/2/58	Labor	10 13			150 00
	10% Overhead	1 01	11 14	2-14-58	84 67
	72' 6" Transite Pipe @ 70		50 40		65 33
	1 6x6 Clay Tee		1 16		
	1 6" Clay Elbow		1 88		
	1 hr. Trucking @ 75		75		
			65 33		
	Owner dug trench				
	Labor				

TOWN OF LEXINGTON—DEPT. OF PUBLIC WORKS
SEWER DIVISION

DATE.....

NO.


The undersigned applies for the construction of a particular sewer connecting No.....
Street and hereby agrees to comply with the Rules and Regulations governing the construction and use of Particular
Sewers, as now or at any future time established by the Board of Selectmen.

Am't of estimate \$.....

Am't Paid \$.....

..... Owner

Sketch of Service Here

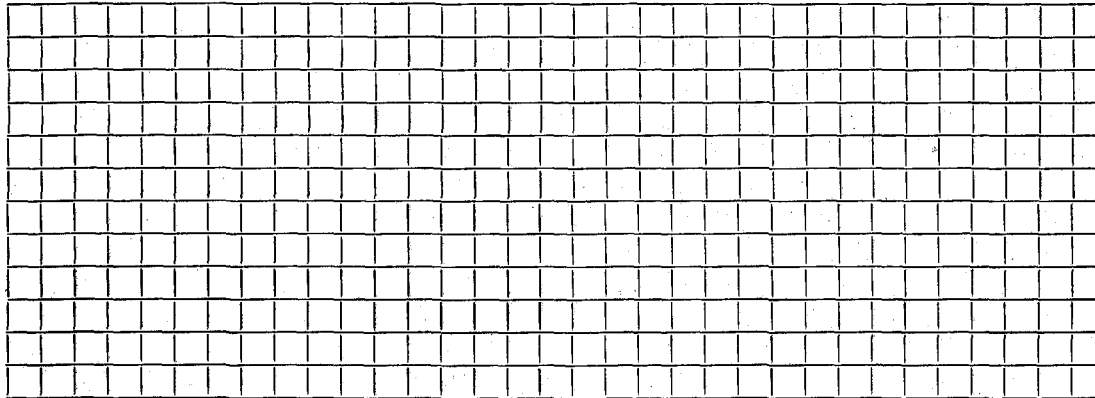

Connection made in..... Street.

Work completed.....19..

Remarks: