

Name Leeland Construction Company

Service No. 66

Address 9 Ross Road, Lexington 73, Massachusetts

9 Ross Road

Location Lot 19

*Order 10-14-58*

Kind of Pipe

Size 6"

Size of Main 8"

~~Repair~~ ~~Renewal~~ New Service

Location

Date	Material	Amount	Total	Date	Amount
4/30/58	Labor	23 69			
	10% Overhead	2 37	26 06		
	63' 6" Transite Pipe @	70	44 10	<i>10-14-58</i>	<i>Repair</i> <i>Pl. by Repair 5 HLT # 43</i>
	1 6" Clay Elbow		1 88		<i>25 00</i> <i>63 90</i> <i>88 90</i>
	4' 6" V.C. Sewer Pipe @	4 35	1 74		
	1 6 x 6 Clay Y		1 16		
	1 6" Clay Adapter		1 90		
	1 11 1/4° Transite Bend		5 10		
	1 22 1/2° Transite Bend		6 21		
	1 hr. Trucking @	75	75		
11-27-78	Repair		88.90		
	1 6" X 12" Nipple				
	1 <del>labor</del> 6" X 22 1/2° Elbow				
	1 4" DONUT				

**TOWN OF LEXINGTON—DEPT. OF PUBLIC WORKS**  
**SEWER DIVISION**

DATE.....

NO. ....

The undersigned applies for the construction of a particular sewer connecting No.....  
Street and hereby agrees to comply with the Rules and Regulations governing the construction and use of Particular  
Sewers, as now or at any future time established by the Board of Selectmen.


Am't of estimate \$.....

Am't Paid \$.....

..... Owner

---

**Sketch of Service Here**

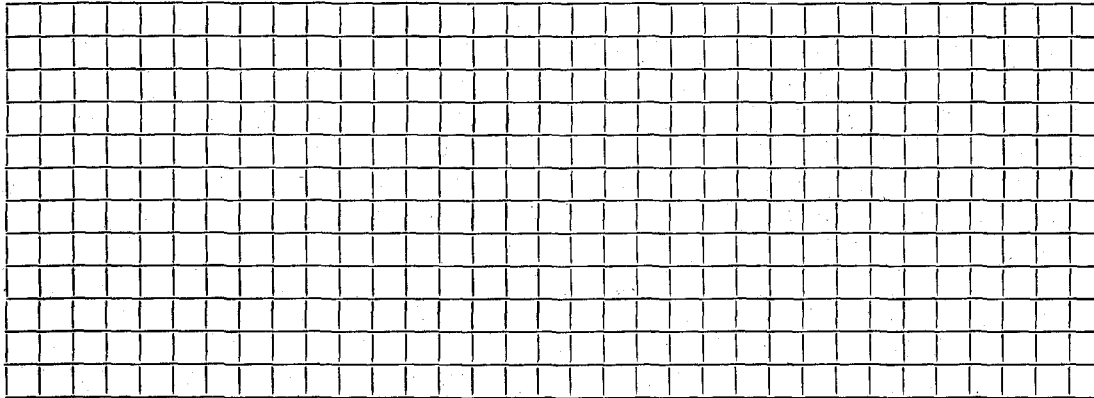

Connection made in..... Street.

Work completed.....19..

Remarks: