




TOWN OF LEXINGTON — BOARD OF PUBLIC WORKS  
SEWER DIVISION

Sketch of Service Here

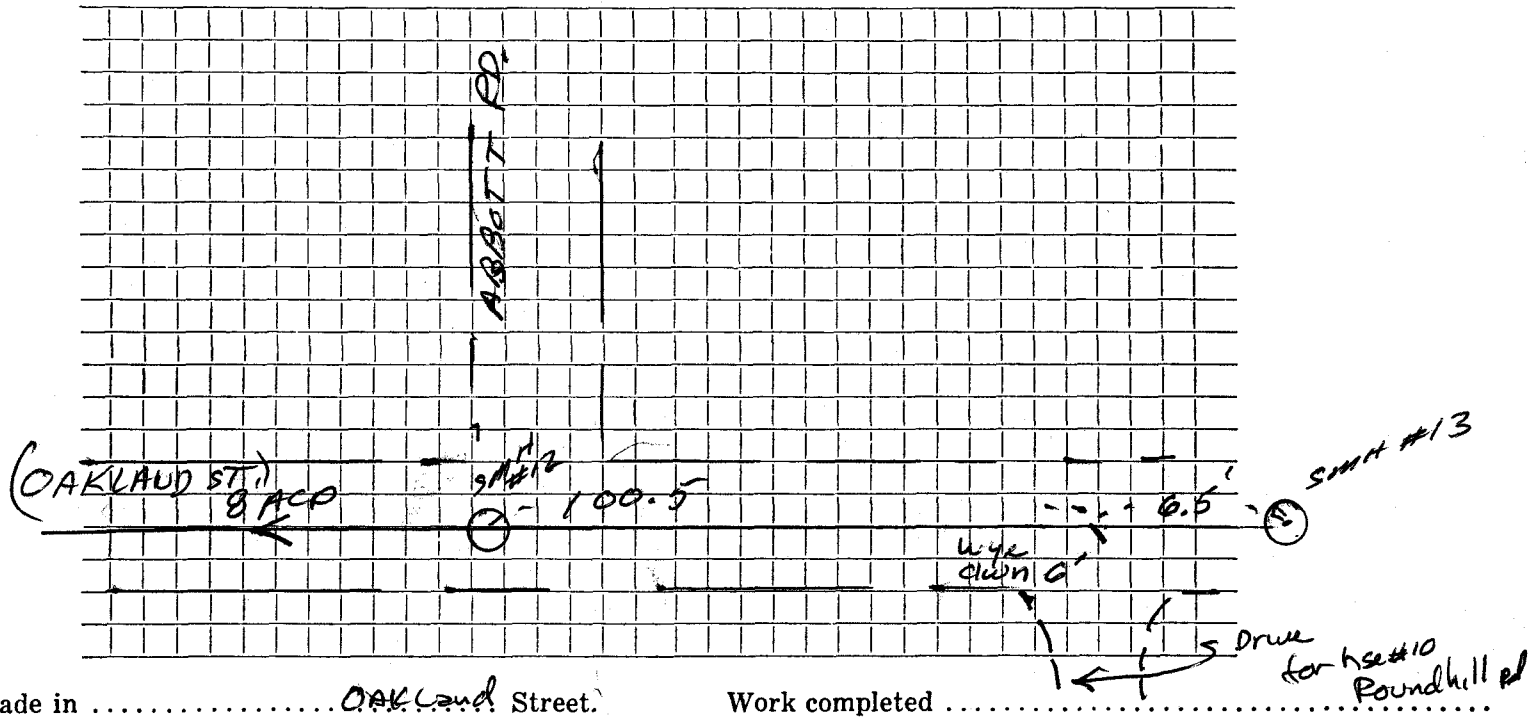

Connection made in ..... OAKLAND Street. Work completed .....

Remarks: .....  
.....  
.....