

Name Atlantic Refining Co. (Howard Johnson)

Service No. 46

Address Route 128

Location

Kind of Pipe

Size

Size of Main

~~REPAIRS~~ New Service

Location JUL 5 1960

Date	Material	Amount	Total	Date	Amount
5-18-60	Labor 92.83	92.83		4-23-60	7.50
5-19-60	" 123.19			July 5 1960	51.23
5-20-60	" 117.86	387.79			801.23
	10% O.H.	38.79	426.67		
	105' 6" Transite pipe @.78		81.90		
	24 ton 1 1/2" Stone @1.50		36.00		
	2x10 Const. 8/8 4/4 134 Bd. Ft. @.14		18.76		
	1x3 Spruce 8/10 pes. 80 Lin. Ft. @.035		2.80		
	2 lbs. #16 Common Nails @.15		.30		
	2 Cans Dura Step @\$.15		6.30		
	19 hrs. Town Shovel @\$.50		123.50		
	13 hrs. Trucking @\$.00		39.00		
	45 hrs. Pumping @1.00		45.00		
	2 hrs. Allis Chalmers @\$.00		6.00		
	1 hr. Rogers Trailer @\$.00		3.00		
	4 hrs. Trojan Loader @\$.00		12.00		
			801.23	Bill sent 7-5-60	51.23

DATE _____

TOWN OF LEXINGTON — BOARD OF PUBLIC WORKS
SEWER DIVISION

Sketch of Service Here

A large rectangular grid of graph paper, consisting of 20 columns and 20 rows of small squares, intended for sketching service details.

Connection made in Street. Work completed

Remarks:
.....
.....

Name N. C. Const. Col

Service No.

Address Route 128

Location

Kind of Pipe

Size

Size of Main

~~Repair/Replacement~~ **New Service** N.C. Const. Col. Permit #285

Location

Date

Material

Amount

Total

Date

Amount

May 1965


8" Transite pipe

DATE _____

TOWN OF LEXINGTON — BOARD OF PUBLIC WORKS

SEWER DIVISION

Sketch of Service Here

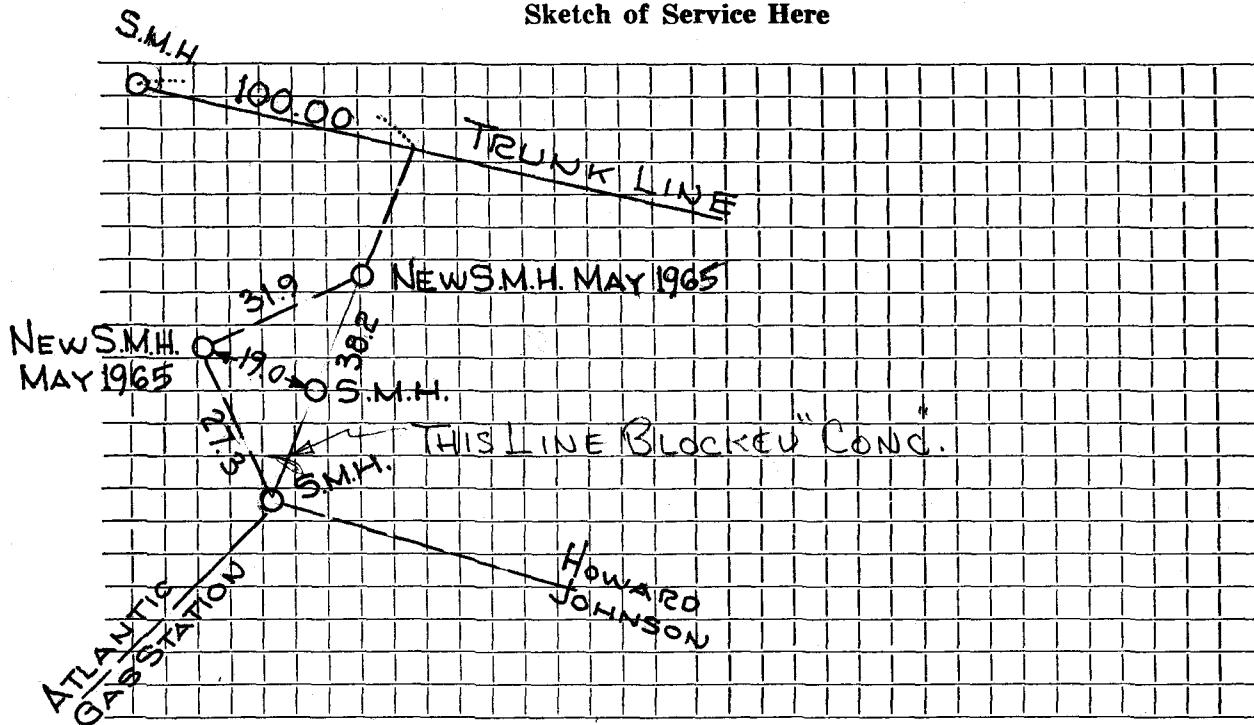

Connection made in Street. Work completed

Remarks:

.....

.....