


DATE 9-12-'90

TOWN OF LEXINGTON — BOARD OF PUBLIC WORKS
SEWER DIVISION

Sketch of Service Here

2

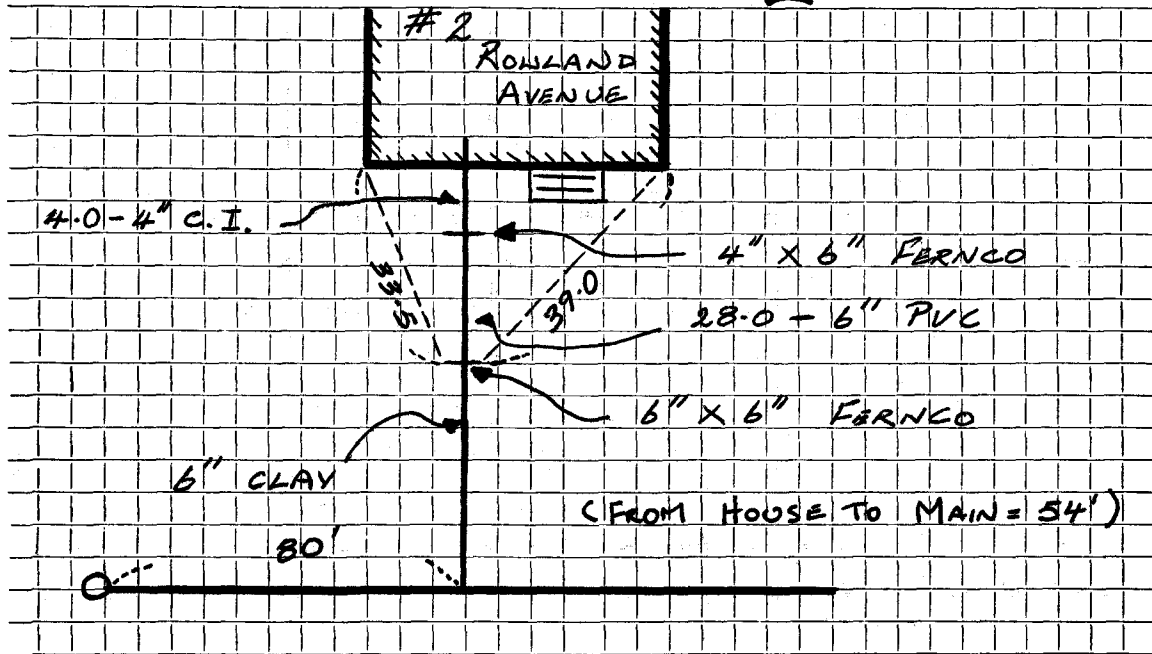

Connection made in ROWLAND AVENUE Street. Work completed

Remarks:

.....