

100017111) MUE

Rowland Ave.

Location 4 Rowland Avenue

Kind of Pipe

Size 6"

Size of Main 8"

Repair Renewal New Service


Location

Date	Material	Amount	Total	Date	Amount
June 16, '44	Labor	33 30	33 30	June 13, '44	90 00
	10% Overhead		3 33	July 25, '44	35 67
	Comp. 2 hrs. @1.75		3 50		54 46
	Trucking 1 hr. @.75		75		
	28' 6" V. C. Pipe @.22		6 16		
	1 6x6 Tee		1 75		
	1 1/2 6" Bend		67		
	10' Iron Soil Pipe @.50		5 00		
			54 46		
	Labor				

Paid

Refunded

4

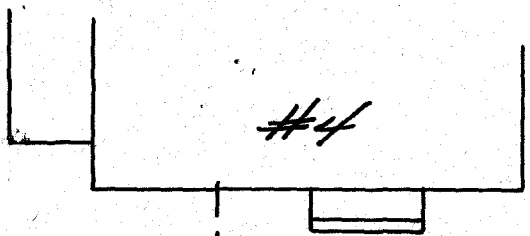

○ Old cess-pool

330



Flowland Ave.