

Name **John McNicholas**

Service No. **101**

Address **5 Rowland Ave.**

Lexington, Mass.

Location

Kind of Pipe

Size **6"**

Size of Main **8"**

~~Repair~~ ~~Renewal~~ **New Service**

Location

Date	Material	Amount.	Total	Date	Amount
Sept. 1, '48	Labor	43 08	43 08	Aug. 24 '48	125 00
	10% Overhead		4 31	Dec. 31 '48	83 89
	46-6" Sewer Pipe @ .26		11 96		91 11
	Joint Compound		2 76		
	3½ hrs. Littlefield Shovel		24 50		
	1 hr. D4 Tractor		3 00		
	2 hrs. Trucking		1 50		
			91 11		
	Labor				

TOWN OF LEXINGTON—DEPT. OF PUBLIC WORKS
SEWER DIVISION

DATE

NO.


The undersigned applies for the construction of a particular sewer connecting No.
Street and hereby agrees to comply with the Rules and Regulations governing the construction and use of Particular
Sewers, as now or at any future time established by the Board of Selectmen.

Am't of estimate \$.

Am't Paid \$.

..... Owner

Sketch of Service Here

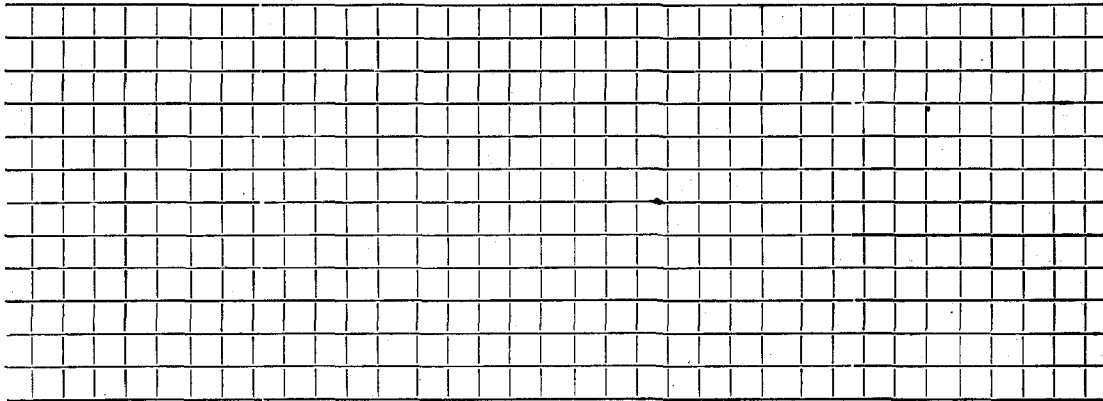

Connection made in Street.

Work completed 19..

Remarks: