

Name Watertown Co-op. Bank

Service No: 31 872

Address ~~Watertown, Massachusetts~~

8 Rowland Ave Location 8 Rowland Avenue

Kind of Pipe

Size 6"

Size of Main 8"

Repair—Renewal—New Service

Location

Date 1941	Material	Amount	Total	Date	Amount
Dec. 5,	44½ hrs. @ 50¢	22 25			
<i>Com 1/27/41</i>	15 " @ 55¢	8 25		<i>Nov. 29, 1941</i>	<i>125 00</i>
	129 " @ 60¢	77 40		<i>Jan. 6, 1942</i>	<i>71 61</i>
	49 " @ 65¢	31 85	139 75	<i>paid</i>	<i>166 61</i>
	10% Overhead		13 97	<i>add bill 11.61</i>	
	42' 6" Sewer Pipe @ 16¢		6 72		
	Joint compound		2 52		
	4 hrs. trucking @ 75¢		3 00		
	1 6" 1/8 Bend		65	<i>Billsent Dec 31, 1941</i>	
			166 61		
	Labor				

Hadley Press, Inc., Lexington

TOWN OF LEXINGTON—BOARD OF PUBLIC WORKS
SEWER DIVISION

DATE Nov. 24, 1941

NO. _____


The undersigned applies for the construction of a particular sewer connecting No. 8 Rowland Avenue Street and hereby agrees to comply with the Rules and Regulations governing the construction and use of Particular Sewers, as now or at any future time established by the Board of Selectmen.

Am't. of Estimate \$ 125.00

~~Am't. of Estimate \$~~ _____

Watertown Cooperative Bank owner
J. Alvarado, Treasurer

Sketch of Service Here

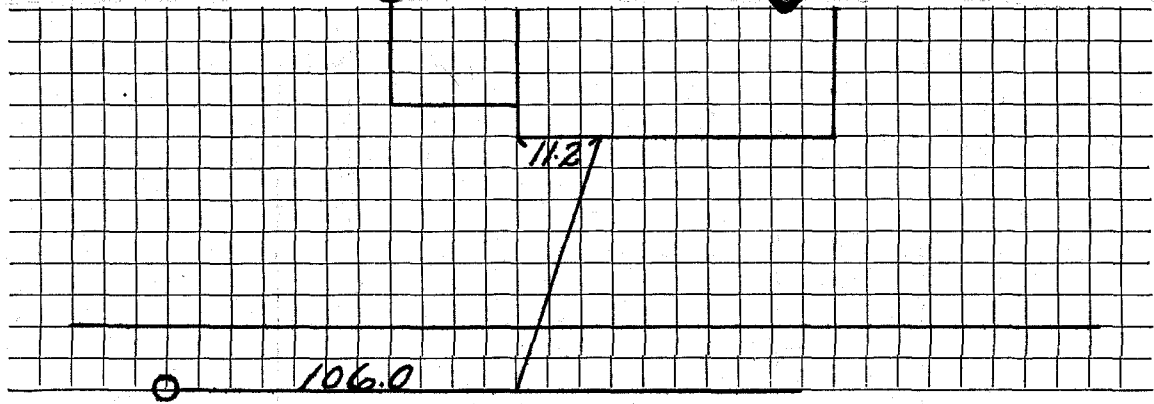

Connection made in _____ Street.

Work completed _____ 19

Remarks: