


DATE _____

TOWN OF LEXINGTON — BOARD OF PUBLIC WORKS
SEWER DIVISION

Sketch of Service Here

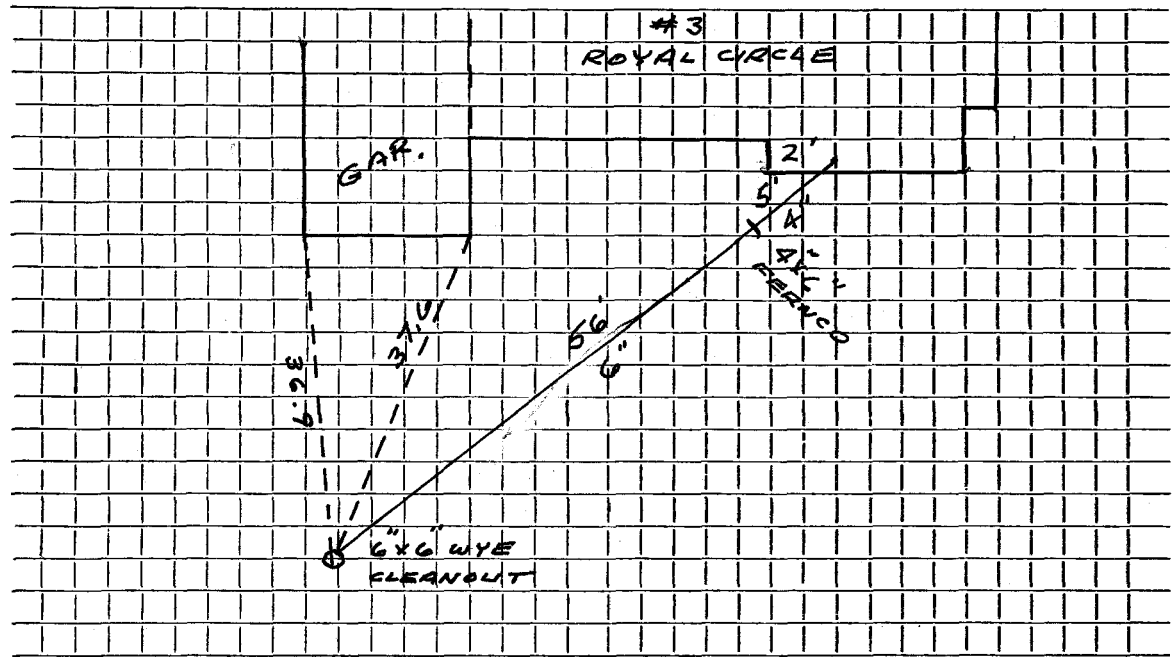

Connection made in ROYAL CIRCLE Street. Work completed

Remarks: CLEANOUT ENCASED IN SONA TUBE
.....
.....